

KANSAS

FORM 51 5M 1-42 PETROL


Barton

Section 24 Township 16 Range 12-W

Well No. #2 Doelcheck (Dolecheik)

Company Black-Marshall

Beaver Pool _{NORTH}

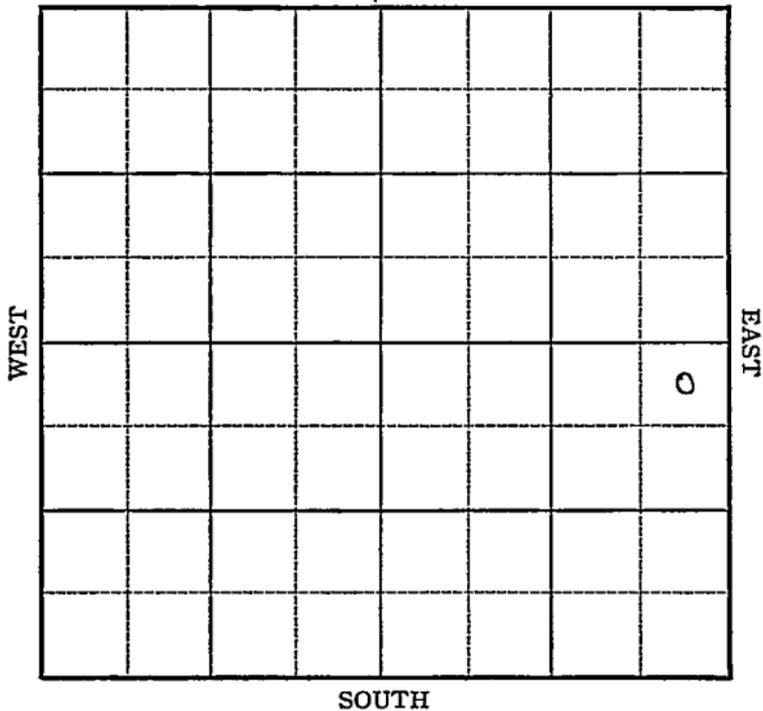

Sec. 24 Twp. 16 R. 12-W

Well No. #2 Doelcheck Farm

Black-Marshall Company


Beaver Pool

330 Ft. from N. Line

_____ Ft. from S. Line

330 Ft. from E. Line

_____ Ft. from W. Line

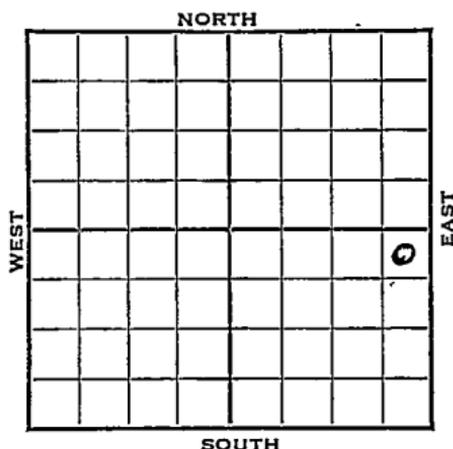

NE SE Elev. 1910

1942

REPORT

11/24	Loc.
12/2	Drk.
12/9	"
12/16	"
12/22	"
12/29	"
1943	
1/6	12" Casing set at 437 Drlg. 636'
1/13	Anhy 736 10" casing set 767' Drlg. 1900'
1/20	TD 2350' SD.
1/27	Drlg. 2580'
2/3	8" @ 2450' Topeka 2710 Drlg. 3025'
2/10	Lans 3880 SSO 3145-53 7" @ 3192' Drlg. 3340'

OVER

1943

2/17 5" Casing set 3360
TD 3372
300' oil in 2 hrs.

2/24 ~~33~~ Arb 3351
TD 3367
Corrected 2890-99 SO.

3/3 1100 acid /
Temp pot 60 bbls oil & 25% water
Pump.

3/10 " " " " "

3/17 . Arb. 3351 - - -
5" @ 3353'
T.D. 3367'
1100 gal acid
Pump 60 bbls oil plus 25% water. Pot.
Gravity 39

COMPLETED

Barton

KANSAS

Map No. 55 Sec. 24 Twp. 16 R. 12WWell No. 2 DoelcheckBlack-Marshall CompanyFIRST REPORT Contractor

NE SE

SECTION PLAT

330 Ft. from N. Line Ft. from S. Line330 Ft. from E. Line Ft. from W. Line

			□

BEAVER POOL

Location XXXRig up

Drilling and Remarks:

RECORD

Cased in., ft.Sand Gas Oil Total Depth

PRODUCTION

1st 24 hrs. Nat. 1st 24 hrs. after shot Gas Cu. Ft.Dry Hole Abandoned

Date

NOV 24 1942 19S. J. LEWIS Scout

Barton

KANSAS
 Map No. 55 Sec. 24 Twp. 16 R. 12W

Well No. 2 Dolecheck

Black-Marshall Company

COMPLETED Contractor

NE SE

SECTION PLAT

330 Ft. from N. Line

_____ Ft. from S. Line

330 Ft. from E. Line

_____ Ft. from W. Line

			D

BEAVER POOL

Location _____

Rig up _____

Drilling and Remarks:

Core 3351
5' @ 3353
1100 aquifer
Pump 60 oil +
25% Water. P.O.Y.
29° Gr

RECORD

Cased _____ in., _____ ft.

Sand _____

Gas _____

Oil _____

Total Depth 3367

PRODUCTION

1st 24 hrs. Nat. _____

1st 24 hrs. after shot _____

Gas _____ Cu. Ft.

Dry Hole _____

Abandoned _____

Date

MAR 17 1943 19

S. J. LEWIS Scout