KANSAS

Form 51—5M—7-39—Palace


Barton

Section 24 Township 16 Range 12-W

Well No. #1 Dolecheck

Company Black, Marshall

Beaver Pool

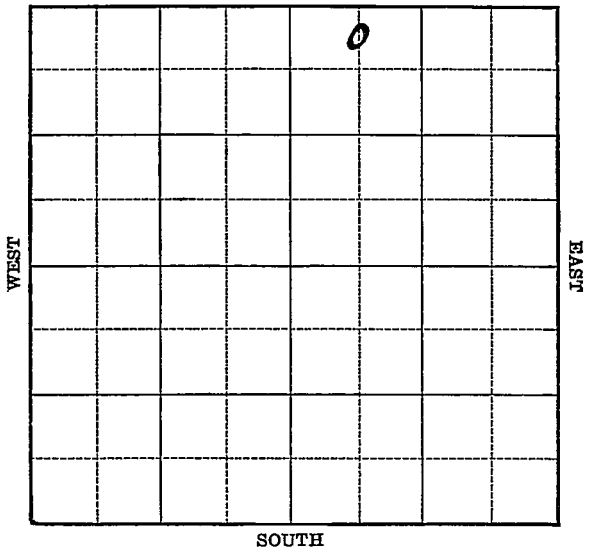

FORM 252-A 5M **KANSAS** Barton

Sec. 24 Twp. 16 R. 12-W

Well No. #1 Dolecheck Farm

Black, Marshall Company


(Beavery)

330 Ft. from N. Line

_____ Ft. from S. Line

_____ Ft. from E. Line

660 Ft. from W. Line

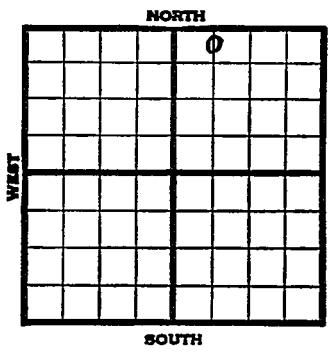

Elev. 1883

1940	REPORT
2/7	Cellar.
2/15	Rig.
2/23	R.U. Cable.
2/29	12½" - 280' Drlg. 580'
3/8	Anhy 748' 10" - 755'
"	Drlg. 1220'
3/14	Drlg. 1470'
3/21	8" - 2425' Topeka 2735'
	Drlg. 2905'
3/28	" "
4/3	Cong. 3335' water.
	T.D. 3391'
	ABANDONED

Form 26—1M Bks.—2-29 Barton KANSAS

Map No. 55 Sec. 24 Twp. 16 R. 12W

Well No. 1 Dolecheck

Black, Marshall Company

Contractor

FIRST REPORT

C N L NW NE

330 Ft. from N. Line


Ft. from S. Line

Ft. from E. Line

660 Ft. from W. Line

BEAVER POOL

SECTION PLAT

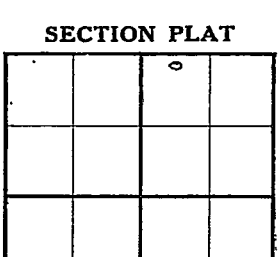

Location

Rig up

Drilling and Remarks:

Cellar

RECORD

Cased in., ft.

Sand

Gas

Oil

Total Depth

PRODUCTION

1st 24 hrs. Nat.

1st 24 hrs. after shot

Gas Cu. Ft.

Dry Hole

Abandoned

Date

FEB 7 1940 19

S. J. LEWIS Scout

Form 26—200 Bks.—1-40—Palace Barton KANSAS

Map No. 55 Sec. 24 Twp. 16 R. 12W

Well No. 1 Dolecheck

Black - Marshall Company

Contractor

ABANDONED

C N L NW NE

330 Ft. from N. Line


_____ Ft. from S. Line

_____ Ft. from E. Line

660 Ft. from W. Line

BEAVER POOL

SECTION PLAT

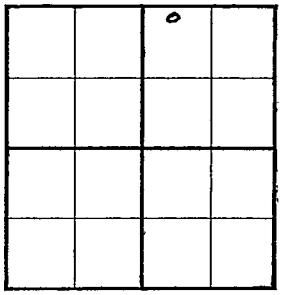

Location_____

Rig up_____

Drilling and Remarks:

Cong 3335.

Water.

RECORD

Cased _____ in., _____ ft.

Sand_____

Gas_____

Oil_____

Total Depth 3391

PRODUCTION

1st 24 hrs. Nat._____

1st 24 hrs. after shot_____

Gas_____ Cu. Ft.

Dry Hole_____

Abandoned_____

Date

APR 3 1940 19

S. J. LEWIS Scout