Form 51—5M—11-38—Palace


Russell KANSAS

Section 17 Township 15 Range 13-W

Well No. #6 L. Sellens

Company Coralena

Coralena South Pool

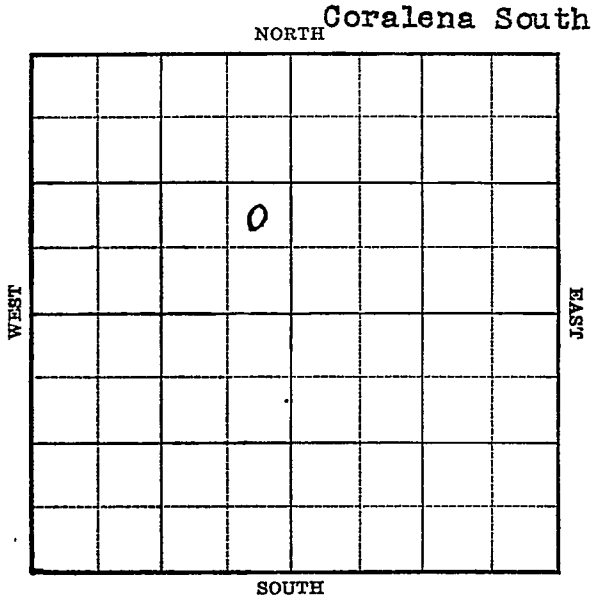

FORM 252-A 5M 4-39 KANSAS - Russell

Sec. 17 Twp. 15 R. 13-W

Well No. #6 L. Sellens Farm

Coralena Company


(South Coralena)

____ Ft. from N. Line

990 Ft. from S. Line

330 Ft. from E. Line

____ Ft. from W. Line

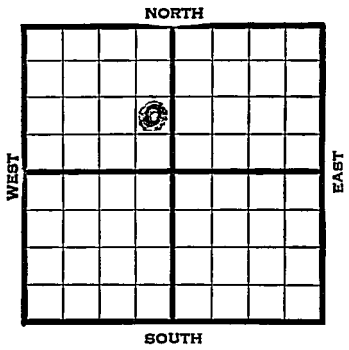

Elev. 1762

1939	REPORT
7/12	Rotary.
7/20	10" - 237' Drlg. 2145'
7/27	Topeka 2650' Lans. 2945'
	Arb. 3188' T.D. 3192'
	7" - 3188' RUST.
8/2	Arb. 3188'
	7" - 3188'
	T.D. 3192'
	4000 acid.
	Echometer potential 3607 bbls.
	Maximum 3000 bbls.
	COMPLETED

Form 26—1M Bks.—2-29

Russell KANSAS

Map No. _____ Sec. 17 Twp. 15 R. 13W

Well No. 6 L. Sellens

Coralena Company

FIRST REPORT Contractor

NE SE NW

_____ Ft. from N. Line


990 Ft. from S. Line

330 Ft. from E. Line

_____ Ft. from W. Line

CORALENA SOUTH POOL

SECTION PLAT

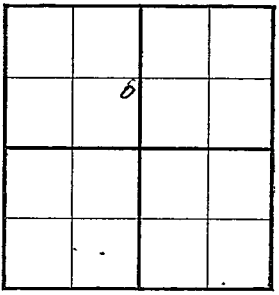

Location _____

Rig up _____

Drilling and Remarks:

Rotary

RECORD

Cased _____ in., _____ ft.

Sand _____

Gas _____

Oil _____

Total Depth _____

PRODUCTION

1st 24 hrs. Nat. _____

1st 24 hrs. after shot _____

Gas _____ Cu. Ft.

Dry Hole _____

Abandoned _____

Date

JUL 12 1939 19

S. J LEWIS Scout

Form 26—1M Bks.—2-29 Russell KANSAS

Map No. Sec. 17 Twp. 15 R. 13W

Well No. 6 L. Sellens

Coralena Company

Contractor

COMPLETED

NE SE NW

Ft. from N. Line


990 Ft. from S. Line

330 Ft. from E. Line

Ft. from W. Line

CORALENA SOUTH POOL

SECTION PLAT

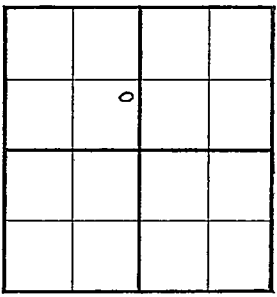

Location

Rig up

Drilling and Remarks:

Ran 3188

7" @ 3188

400 cmt

Eckometer 24

3607

Magnesium 3068

RECORD

Cased in., ft.

Sand

Gas

Oil

Total Depth 3192

PRODUCTION

1st 24 hrs. Nat.

1st 24 hrs. after shot

Gas Cu. Ft.

Dry Hole

Abandoned

Date

AUG 2 1939 19

S. J. LEWIS Scout

O.W.W.O.

Twp. X Pool X

Rge. X Farm X

S—513-B

Co.

County Russell Elev. 1762 DF

Sec. 17 Twp. 15 Rge. 13W

Company C. P. A., Kepler & Boone

Farm Name L. Sellens No. 6

TOPS	DEPTH	LOG	DATUM
Anh.			
Tp.	2650		
H.			
Tr.			
Dg.			
B. L.			
LK	2945		
K.C.			
B.K.C.			
Ce.			
C.			
M.			
M.			
K.			
Mz.			
Mq.			
V.			
S.			
S.			
A.	3188		
R.			
Pf.			
G.			
T.D.			

Loc. in Sec. NE SE NW (O.W.W.O.)

Geol. O.W.W.O.

Contr.

Lse.

Pool Trapp

COMPLETE FIRST REPORT JUL 2 58

No.

Date Comm. OLD INFO: TDps. Arb Well 7-27-39. NEW INFO: SPUD 7-1-58, MICT CO (Corr. Arb. to 3182) PB 3159, /3114-20, /3020-34, /2953-73, 1500/A @ 3114-20 2000/A @ 3020-34, Swab 48 BO plus 39 BW/20 hrs from 3020-24 Swb 31 BO & 30 BW/17 hrs, 3114-20, 500A @ 2953-73, Swb 1.16 BOPH 2 hrs, POP P 88 BO & 8 BW/24 hrs. COMPIETE LK Prod.

Sec. T. R.