


Map No. Kansas Sec. 21 Twp. 33 R. 3E

Well No. 3 Ike Nelson Farm
Waite Phillips Company

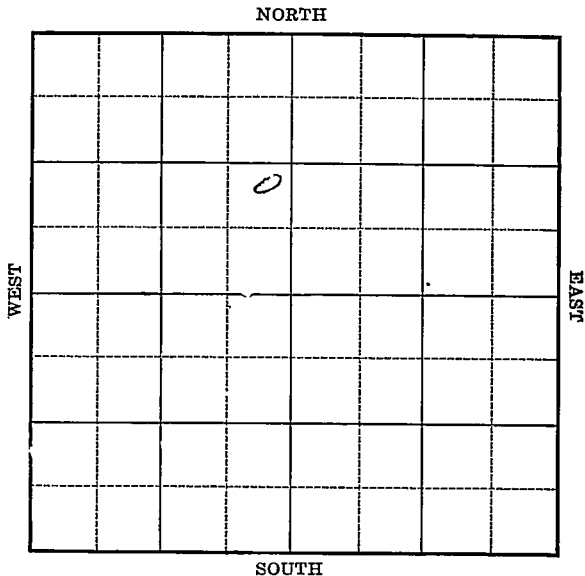

Location _____

Drilling Remarks

RECORD

Cased _____ in. _____ ft.

Sand _____

Gas _____

Oil _____

Total Depth _____

Rig Up _____

Drilling Remarks

PRODUCTION

1st 24 hrs. Nat. _____

1st 24 hrs. after shot _____

Gas _____ cu. ft.

Dry Hole _____

Abandoned _____

Map No. **KANSAS** Sec. 21 Twp. 83 R. 31

Well No. 3 Ike Nelson

Waite Phillips Company

Contractor

SECTION PLAT

	0		

----- Ft. from N. Line

990 Ft. from S. Line

330 Ft. from E. Line

----- Ft. from W. Line

FIRST REPORT

Location -----

Rig up -----

Drilling and Remarks:

Cellar

RECORD

Cased ----- in., ----- ft.

Sand -----

Gas -----

Oil -----

Total Depth -----

PRODUCTION

1st 24 hrs. Nat. -----

1st 24 hrs. after shot -----

Gas ----- Cu. Ft.

Dry Hole -----

Abandoned -----

Date

SEP 16 1925

S. J. LEWIS

Scout

Map No. KANSAS Sec. 21 Twp. 33 R. 3E

Well No. 3 Ike Nelson

Waite Phillips Company

Contractor

SECTION PLAT

-----Ft. from N. Line

990 Ft. from S. Line

330 Ft. from E. Line

-----Ft. from W. Line

	0		

COMPLETED

Location -----

Rig up -----

Drilling and Remarks:

TS 3216

Gas 3220

Oil 3228

BS 3242

TS 3244

365 x 8 1/2 24 hrs

RECORD

Cased ----- in., ----- ft.

Sand -----

Gas -----

Oil -----

Total Depth -----

PRODUCTION

1st 24 hrs. Nat., -----

1st 24 hrs. after shot -----

Gas ----- Cu. Ft.

Dry Hole -----

Abandoned -----

Date

DEC 2 - 1925
192

S. J. LEWIS

Scout