

KANSAS


Russell

FORM 51 5M 11-44 PETROL

Section 5 Township 15 Range 14W

Well No. #1 Phinney

Company John Lindas

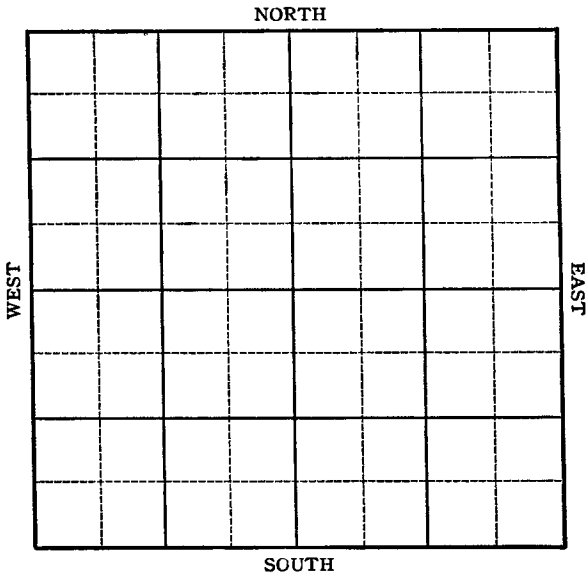

KANSAS

Russell

Sec. 5 Twp. 15 R. 14W


Well No. #1 Phinney Farm
John Lindas
Trapp Company

 Ft. from N. Line

990 Ft. from S. Line

990 Ft. from E. Line

 Ft. from W. Line

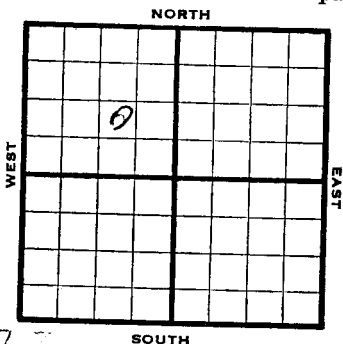

NW SE NW

177

SOUTH

1945

R E P O R T

3/7	Location	
3/14	10-3/4 @ 250	WOC
3/23	Anhy 788	
	Drlg. 2608	
3/29	Lans 2958	
	7" @ 2985	
	TD 2993	
	Sat RUST	
4/5	Bail 1 1/3 oil per hr.	
4/12	2500 acid. swb. 6 oil PH	
4/20	" " " " " "	
4/27	" " " " " "	
5/3	" " " " " "	
5/16	Lans 2958	
	7" @ 2958	
	TD 2993	
	2500 acid.	
	Pump 297 Pot.	
	Grav. 35.7	

COMPLETED

Pool Name TrappMap No. 73 Sec. 5 Twp. 15 R. 14WWell No. 1 PhinneyJohn Lindas


Company

FIRST REPORT

Contractor

NW SE NW

SECTION PLAT

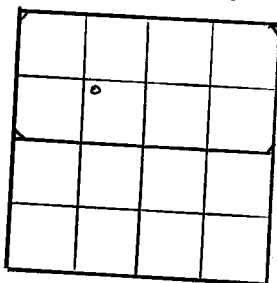

Ft. from N. Line

990 Ft. from S. Line990 Ft. from E. Line

Ft. from W. Line

RussellLocation x

Rig up

Drilling and Remarks:

RECORD

Cased _____ in., _____ ft.

Sand _____

Gas _____

Oil _____

Total Depth _____

PRODUCTION

1st 24 hrs. Nat. _____

1st 24 hrs. after shot _____

Gas _____ Cu. Ft.

Dry Hole _____

Abandoned _____

Date

MAR 7 1945 19

S. J. LEWIS Scout


Kansas Pool Name TrappMap No. 73 Sec. 5 Twp. 15 R. 14WWell No. #1 PhinneyJohn Lindas

Company

COMPLETED

Contractor

NW SE NW

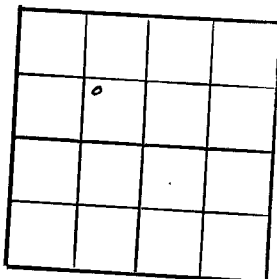E¹/1772
SECTION PLAT

Ft. from N. Line

990

Ft. from S. Line

990

Ft. from E. Line

Ft. from W. Line

Russell County

Location

Rig up

Drilling and Remarks:

Lane 2958.7" @ 2958.2500 acidProd 287 Bbl.357 Bbl

RECORD

Cased _____ in., _____ ft.

Sand _____

Gas _____

Oil _____

Total Depth 2989

PRODUCTION

1st 24 hrs. Nat. _____

1st 24 hrs. after shot _____

Gas _____ Cu. Ft.

Dry Hole _____

Abandoned _____

Date

MAY 16 1945

19

S. J. LEWIS Scout