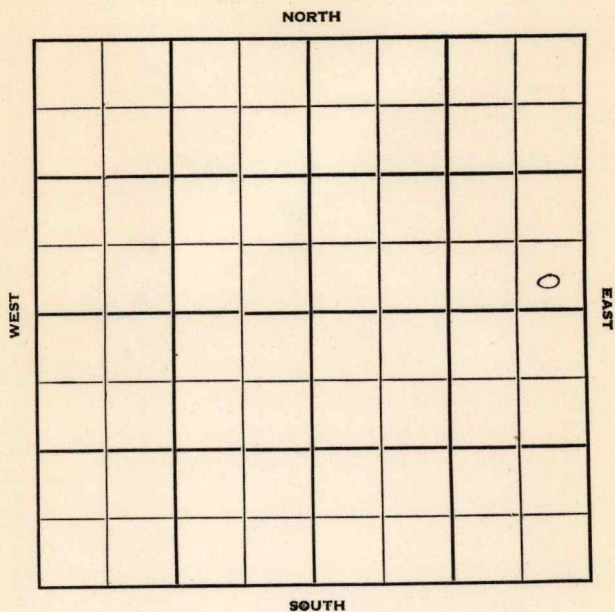


Section 22 Township 13 Range 14WWell No. #4 HollandCompany National Cooperative Refinery Assn.

Russell

KANSAS

Sec. 22 Twp. 13 R. 14W ✓

Well No. #4 Holland Farm

National Cooperative Ref. Assn Company

Contractor

Russell


Ft. from N. Line

330' Ft. from S. Line

330' Ft. from E. Line

Ft. from W. Line

SE SE NE

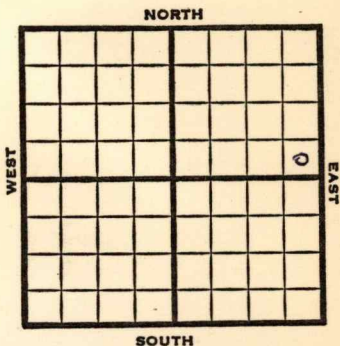

1951

Elev. 1844' REPORT

10/17 Cellar & Pits

1952

1/30

Spud 1-12-52

D&A TD 3330

8" @ 159

Lans. 3009

DST 3043-58 open 2 hr. rec. 30'

mud 5' OCM

DST 3170-3208 open 2 hr. rec. 10'

mud **Arb. 3298**

DST 3300-30 open 1 hr. rec. 1675' SW

TD 3330'

D&A

ABANDONED

County **Russell** State **Kansas**
 Sec. **22** (Blk.) **13** (Sur.) **14W** Map No.
 (Twp.) (Rge.)
 Operator **National Cooperative Refinery Assn.**
 Well No. **4** Farm **Holland**
 Elev. Location **SE SE NE**

FIRST REPORT**330** Ft. From **S** Line **NE****330** Ft. From **E** Line Quarter1st. Report **OCT 17 1951**


Completion

Remarks

Spudding Date

Drlg. Data **Russell****Cellar & pits****J. E. TYRA**

County Russell State Kansas
 Sec. 22 (Blk. 13) (Sur. 14W) Map No. _____
 Operator National Cooperative Refinery Assn.
 Well No. 4 Farm Holland
 Elev. 1844 Location SE SE NE

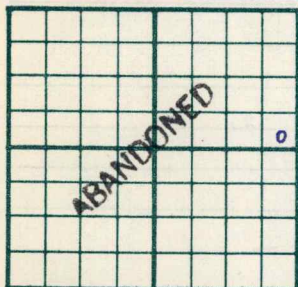

330 Ft. From S Line NE

330 Ft. From E Line Quarter

1st. Report

Completion JAN 30 1952Remarks Russell PoolSpudding Date 1-12-52Drilg. Data D & A TD 33308" @ 159 Lans. 3009 DST 3043-58open 2 hr. Rec. 30' mud 5' ocmDST 3170-3208 open 2 hr. Rec. 10' mudArb. 3298 DST 3300-30 open 1 hr.Rec. 1675' sw TD 3330D & A

J. G. McGEHEE