

Map No. Kan Sec. 21 Twp. 33 R. 3E


Well No. 1 of Snyder Farm
Waite-Phillips Company

_____ Ft. from N. Line

990 Ft. from S. Line

990 Ft. from E. Line

_____ Ft. from W. Line

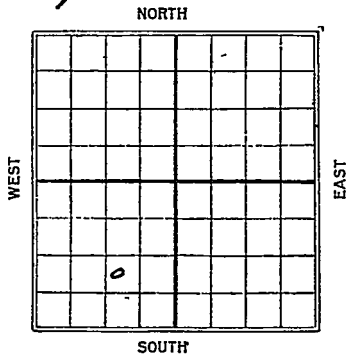

B

Date	REPORT
1925	
7/22	Location
7/29	Rig in up.
8/7	Spud.
8/14	700
8/19	725
8/27	755'
9/12	1555
9/19	1930'
9/16	2035 psy tools
9/24	_____
9/30	_____
10/6	Skid Rig
10/13	Rig in up
10/21	300'
10/28	630'
11/4	740
11/11	Skidding rig
11/18	Rig in up
1926	
2/19	Top sand 3248 T.D. 3281
	150 barrels

Map/No. **KANSAS** Sec. 21 Twp. 33 R. 3^E

Well No. 2 W Snyder

Watts Phillips Company

Contractor

FIRST REPORT

SECTION PLAT

----- Ft. from N. Line

990 Ft. from S. Line

990 Ft. from E. Line

----- Ft. from W. Line

	o		

Location

Rig up -----

Drilling and Remarks: -----

RECORD

Cased ----- in., ----- ft.

Sand -----

Gas -----

Oil -----

Total Depth -----

PRODUCTION

1st 24 hrs. Nat. -----

1st 24 hrs. after shot -----

Gas ----- Cu. Ft.

Dry Hole -----

Abandoned -----

Date

JUL 22 1925

M. A. BENEAR

192

Scout

121

Cowley

Map No. **KANSAS** Sec. *21* Twp. *33* R. *3E*

Well No. *2 - Wm Snyder*

Waite Phillips Company

Contractor

SECTION PLAT

-----Ft. from N. Line

990 Ft. from S. Line

990 Ft. from E. Line

-----Ft. from W. Line

	0		

COMPLETED

Location -----

Rig up -----

Drilling and Remarks:

T.S. 3248 S.W.

T.D. 3281

150 yds.

RECORD

Cased ----- in., ----- ft.

Sand -----

Gas -----

Oil -----

Total Depth -----

PRODUCTION

1st 24 hrs. Nat. -----

1st 24 hrs. after shot -----

Gas ----- Cu. Ft.

Dry Hole -----

Abandoned -----

Date

MAR 9

1936

S: J. LEWIS

Scout