


Russell

Form 51—5M—11-31—Palace

Map No. **KANSAS** Sec. *22* Twp. *13* R. *14^W*

Well No. *1 Steirle* Farm
Tom Palmer Company

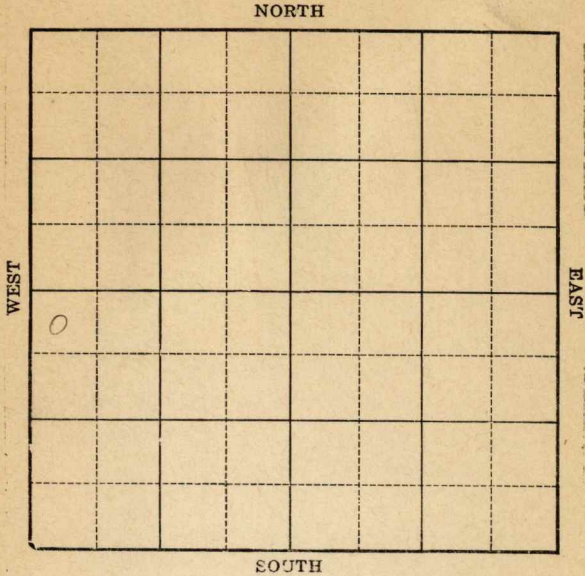

Location _____
Drilling Remarks _____

Rig Up _____
Drilling Remarks _____

RECORD

Cased _____ in. _____ ft.
Sand _____
Gas _____
Oil _____
Total Depth _____

PRODUCTION

1st 24 hrs. Nat. _____
1st 24 hrs. after shot _____
Gas _____ cu. ft. _____
Dry Hole _____
Abandoned _____

Russell

Map No. **KANSAS** Sec. 22 Twp. 13 R. 14


Well No. 1 Steirle Farm
Tom Palmer Company

330' Ft. from N. Line

_____ Ft. from S. Line

_____ Ft. from E. Line

330' Ft. from W. Line

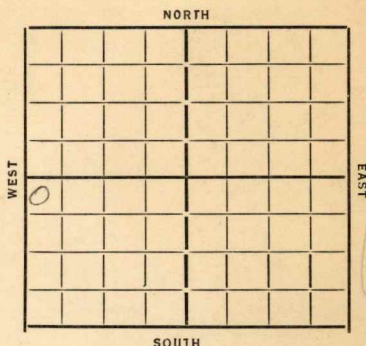

Date 1933

REPORT

11/22 Bldg Rig

11/29

12/6 Riggging Up.

12/13 20"-38' dly 290

12/27 T.D. 870 U.R. 12"

1/11 dreg 2020

1/17 10" at 2175

8" " 2510

dreg 2605

1/24 8" at 2774

Show oil 2795

dreg 2860

1/31 Top Oswald 3005 Run 6" 3060

2/7 show oil 3180 HFW 3185 TD 3193
U R 6"

2/13 Top Sil. 3283 TD 3286 Hole
full oil Show 36 Corrected

2/21 Silicous 3275 Pay 3283-86
TD 3286 Pump 1089 Bbls.

COMPLETED

Map No. 72 Sec. 22 Twp. 13 R. 14W

Well No. 1-Steinle

Tom Palmer

Company

Contractor

SECTION PLAT

330 Ft. from N. Line

Ft. from S. Line

Ft. from E. Line

330 Ft. from W. Line

FIRST REPORTS

Location

Rig up

Drilling and Remarks:

B.R.

RECORD

Cased in., ft.

Sand

Gas

Oil

Total Depth

PRODUCTION

1st 24 hrs. Nat.

1st 24 hrs. after shot

Gas Cu. Ft.

Dry Hole

Abandoned

Date

11-22-33 192

O. Mennich Scout

Map No. 72 Sec. 22 Twp. 13 R. 14W

Well No. 1-Steinle

Tom Palmer Company

Contractor

COMPLETED

SECTION PLAT

330 Ft. from N. Line

..... Ft. from S. Line

..... Ft. from E. Line

330 Ft. from W. Line

0			

Location.....

Rig up.....

Drilling and Remarks:

pay 3283-86

pump 1089
bbls

RECORD

Cased..... in., ft.

Sand silicious 3275

Gas.....

Oil.....

Total Depth 3286

PRODUCTION

1st 24 hrs. Nat.....

1st 24 hrs. after shot.....

Gas..... Cu. Ft.

Dry Hole.....

Abandoned.....

Date

2-21-34 192 O. Mannschreck Scout