

Russell


Form 51-5M-5-34-Palace

Map No. **KANSAS** Sec. 22 Twp. 13 R. 14W

Well No. 2 Steiner Farm

John Palmer Company

NORTH

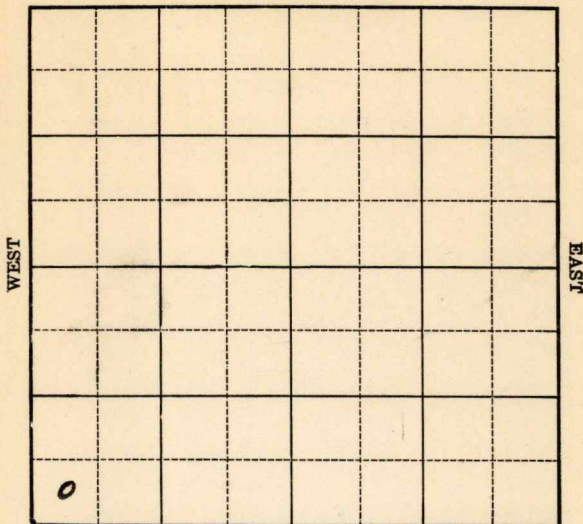

SOUTH

Location _____

Drilling Remarks _____

Rig Up _____

Drilling Remarks _____

RECORD

Cased _____ in. _____ ft.

Sand _____

Gas _____

Oil _____

Total Depth _____

PRODUCTION

1st 24 hrs. Nat. _____

1st 24 hrs. after shot _____

Gas _____ cu. ft.

Dry Hole _____

Abandoned _____

Russell

Map No. KANSAS Sec. 22 Twp. 13 R. 14^W


Well No. 2 Steink Farm
Gom Palmer Company

 Ft. from N. Line

330 Ft. from S. Line

 Ft. from E. Line

330 Ft. from W. Line

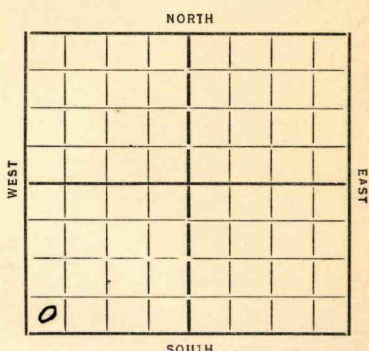

Date 1934

REPORT

9/5 Location
9/13 Rign up
9/20 9/27 —
10/4 Dly 490 15½ 360
10/11 " 885 12½ 644
10/18 " 1845 12½ 855 T Ralt 1305
10/25 2^m Gas 2390-97 10" 2377
Dly 2520
11/1 40" 2503 Topuka 2700
S.O. 2705 Dly 2710
11/8 Aswell 2990 HFW 3020
S.O. 3035-40 6" 3171 3187 CO
11/15 Siliceous 3265 6" 3264
Oil 3268 P.B.P.
11/21 Siliceous 3265 T) 3273
1000 acid 1898 Bbls.

COMPLETED

KANSAS

Map No. 72 Sec. 22 Twp. 13 R. 14WWell No. 2-SteinleTompalmer Company

Contractor

FIRST REPORTS

SECTION PLAT

_____ Ft. from N. Line

330 Ft. from S. Line

_____ Ft. from E. Line

330 Ft. from W. Line

Location ✓

Rig up _____

Drilling and Remarks:

RECORD

Cased _____ in., _____ ft.

Sand _____

Gas _____

Oil _____

Total Depth _____

PRODUCTION

1st 24 hrs. Nat. _____

1st 24 hrs. after shot _____

Gas _____ Cu. Ft.

Dry Hole _____

Abandoned _____

Date

9-5-37

19

ORVAL MANNSCHRECK

Scout

Map No. 72 Sec. 22 Twp. 13 R. 14WWell No. 2-SteinleTompalsme Company

Contractor

COMPLETED

SECTION PLAT

_____ Ft. from N. Line

330 Ft. from S. Line

_____ Ft. from E. Line

330 Ft. from W. Line

Location _____

Rig up _____

Drilling and Remarks:

1000 acid1898 lbs

RECORD

Cased _____ in., _____ ft.

Sand sluans 3265

Gas _____

Oil _____

Total Depth 3273

PRODUCTION

1st 24 hrs. Nat. _____

1st 24 hrs. after shot _____

Gas _____ Cu. Ft.

Dry Hole _____

Abandoned _____

Date

11-21-34 19

ORVAL MANNSCHRECK

Scout