


Map No. **KANSAS** Sec. **22** Twp. **13** R. **14 W**
 Well No. **4-Steinly** Farm _____
Tom Palmer Company _____

NORTH

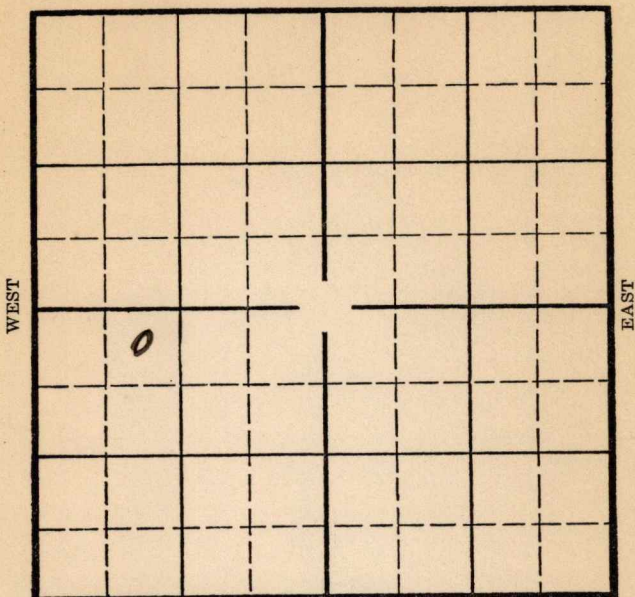

SOUTH

Location _____
 Drilling Remarks _____

Rig Up _____
 Drilling Remarks _____

RECORD

Cased _____ in. _____ ft.
 Sand _____
 Gas _____
 Oil _____
 Total Depth _____

PRODUCTION

1st 24 hrs. Nat. _____
 1st 24 hrs. after shot _____
 Gas _____ cu. ft.
 Dry Hole _____
 Abandoned _____

Russell

Map No. _____ Sec. 22 Twp. 13 R. 14^W

Well No. 4 - Steele Farm Low Palmer Company

330


Ft. from N. Line

Ft. from S. Line

Ft. from E. Line

990

Ft. from W. Line

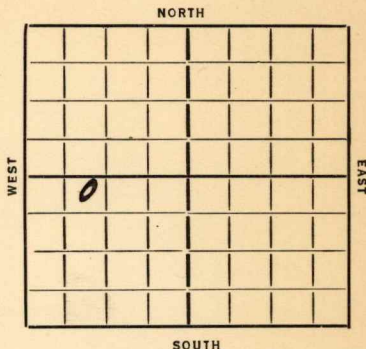

Date _____

REPORT

12/11

15" 364

12ⁿ 849

slg 1165

12/19

12 1985

12/26

" 2525

1/2/36

— 12 1 3000

1410

10" 2491 Top Land. 3010
8" 3018 HFW 3030-34 6" 3250

200 lib 32693274

Page 3294-77

27/5' 05' H S.D.

1/17

Correction

Top Lansing 3000

Top Lib 3274

723271 C.O.
11 2451

1/22

Sil 5274
 5277

72 32/1

1000 acres
1509 fl.

150/1501 and a line

COMPLETED

KANSAS

Map No. 72 Sec. 22 Twp. 13 R. 14W

Well No. 4 - Steink

Tona Palmer Company

Contractor

FIRST REPORTS

SECTION PLAT

330 Ft. from N. Line

..... Ft. from S. Line

..... Ft. from E. Line

990 Ft. from W. Line

0			

Location.....

Rig up.....

Drilling and Remarks:

15" @ 364

12 - 849

alg. - 1165

RECORD

Cased..... in., ft.

Sand.....

Gas.....

Oil.....

Total Depth.....

PRODUCTION

1st 24 hrs. Nat.....

1st 24 hrs. after shot.....

Gas..... Cu. Ft.

Dry Hole.....

Abandoned.....

Date

OPVAL MANNSCHRECK

12-11-35 192..... Scout

Map No. 72 Sec. 22 Twp. 13 R. 14W

Well No. 4 - Steinkle

Tom Palmer Company

Contractor

SECTION PLAT

330 Ft. from N. Line

Ft. from S. Line

Ft. from E. Line

940 Ft. from W. Line

COMPLETED

0			

Location

Rig up

Drilling and Remarks:

1000 acid

1509 Bbls

Shs. water

RECORD

Cased _____ in., _____ ft.

Sand 516. 3274

Gas _____

Oil _____

Total Depth 3277

PRODUCTION

1st 24 hrs. Nat. _____

1st 24 hrs. after shot _____

Gas _____ Cu. Ft.

Dry Hole _____

Abandoned _____

Date

JAN 22 1936

CRAIG MANNSCHEIDT

192 Scout