


DX 78-1

Section 22 Township 13 Range 11W

Well No. #3 Sellens

Company Lewis Mai

NORTH

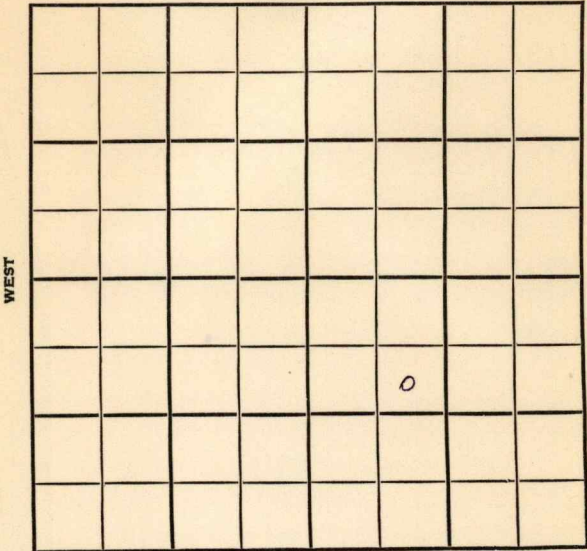

SOUTH

Russell

KANSAS

SEC.	TWP.	R.
22	13	14 W

WELL NO. \_\_\_\_\_

COMPANY # 3 Sellens FARM

CONTRACTOR Lewis Mai


Mast Drlg.  
Russell Townsite Pool

990 \_\_\_\_\_ Ft. from N. Line

\_\_\_\_\_ Ft. from S. Line

\_\_\_\_\_ Ft. from E. Line

990 \_\_\_\_\_ Ft. from W. Line

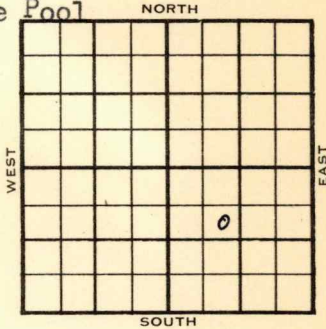

SE NW SE

1954	ELEVATION 1847'	REPORT
------	-----------------	--------

9/1 Spud 8-25-54  
8" @ 192 Anhy 863  
Drlg. 2511'

9/15 Spud 8-25-54 Oil well TD 3281  
8" @ 192 Anhy 863 Heeb 2940  
Lans. 2999 Arb. 3278 TD 3280  
5" @ 3279 DD 3281 500 A  
FU 1400' oil 12 hr. S/3 BOPH 8 hr.  
omp. 25 BOPD

**COMPLETED**



