

KANSAS


Barton

FORM 51 5M 6-46 PETROL

Section 24 Township 16 Range 12-W

Well No. #7 Dolecheck

Company Black-Marshall

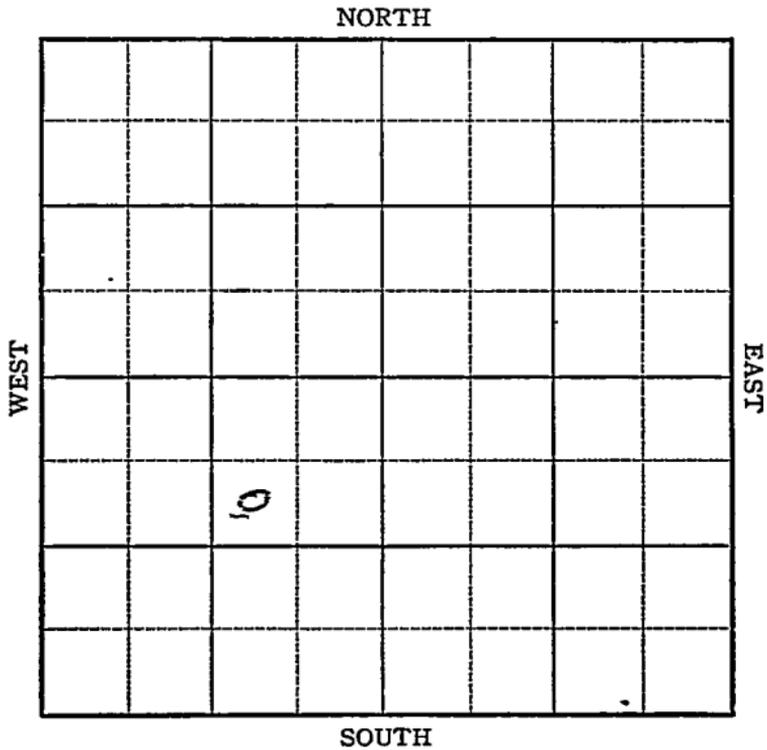

KANSAS

Barton County ✓

Sec. 24 Twp. 16 R. 12W

Well No. #7 Dolecheck Farm
Black-Marshall Company


Kraft-Prus a

990 Ft. from N. Line

_____ Ft. from S. Line

990 Ft. from E. Line

_____ Ft. from W. Line

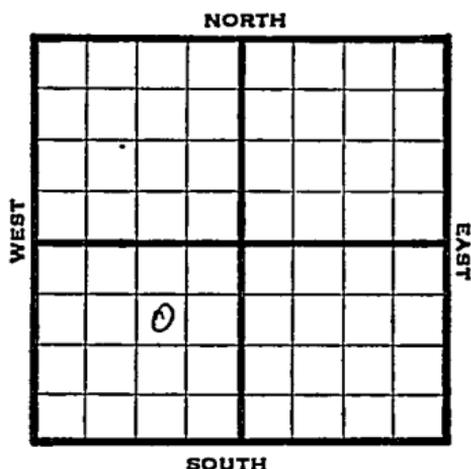

SW NE SW

1946 1900 REPORT

8/14 Location
8/20 "
8/27 8" @ 282
Drlg 2060'
9/5 Lans 3080 G
Gorham 3331-
TD 3333
5" @ 3332, RUST
9/10 TD 3336'
Swb 7 oil PH 5-hrs
9/18 " "
9/25 Gorham 3331'
5" @ 3331'
TD 33368
Pump 306 POT
Grav 42

COMPLETED

~~KANSAS~~ Kansas Pool Name Kraft-Prusa

Map No. 55 Sec. 24 Twp. 16 R. 12W

Well No. 7 Dolecheck

Black-Marshall Company

FIRST REPORT Contractor

SW NE SW

SECTION PLAT

990 Ft. from N. Line

_____ Ft. from S. Line

990 Ft. from E. Line

_____ Ft. from W. Line

	o		

Barton County

Location X

Rig up _____

Drilling and Remarks:

RECORD

Cased _____ in., _____ ft.

Sand _____

Gas _____ :

Oil _____

Total Depth _____

PRODUCTION

1st 24 hrs. Nat. _____

1st 24 hrs. after shot _____

Gas _____ Cu. Ft.

Dry Hole _____

Abandoned _____

Date

AUG 14 1946

19

S. J. LEWIS Scout

Kansas Pool Name Kraft-Prusa Pool

KANSAS

Map No. 55 Sec. 24 Twp. 16 R. 12W

Well No. 7 Dolecheck

Black-Marshall Company

COMPLETED

Contractor

SW NE SW

E11900
SECTION FLAT

990 Ft. from N. Line

 Ft. from S. Line

990 Ft. from E. Line

 Ft. from W. Line

Barton County

Location _____

Rig up _____

Drilling and Remarks:

Lockham 3331
5" casing
Pump 306 ft

42 - 1/2

RECORD

Cased _____ in., _____ ft.

Sand _____

Gas _____

Oil _____

Total Depth 3336

PRODUCTION

1st 24 hrs. Nat. _____

1st 24 hrs. after shot _____

Gas _____ Cu. Ft.

Dry Hole _____

Abandoned _____

Date

SEP 25 1946

19

S. J. LEWIS Scout