


Form 51—5M—11-31—Palace

Map No. _____ Sec. 22 Twp. 13 R. 14W

Well No. 1 Mollie Farm _____
Tom Palmer Company _____

NORTH

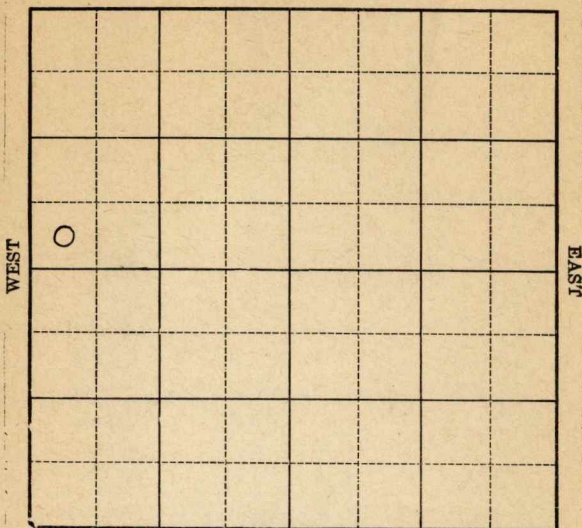

SOUTH

Location _____
 Drilling Remarks _____

Rig Up _____
 Drilling Remarks _____

RECORD

Cased _____ in. _____ ft.
 Sand _____
 Gas _____
 Oil _____
 Total Depth _____

PRODUCTION

1st 24 hrs. Nat. _____
 1st 24 hrs. after shot _____
 Gas _____ cu. ft.
 Dry Hole _____
 Abandoned _____

Russell

Map No. KANSAS Sec. 22 Twp. 13 R. 14W

Well No. 1 Hollk Farm


Tom Palmer Company

 Ft. from N. Line

330 Ft. from S. Line

 Ft. from E. Line

330 Ft. from W. Line

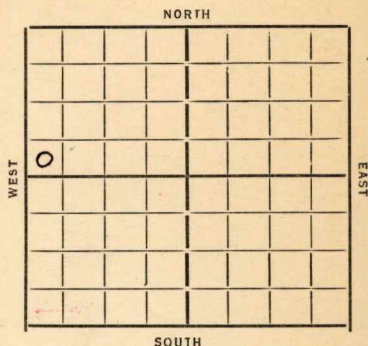

Date 7/24

REPORT

3/7 Bldg Rig

3/15 Rig

3/22 Rign up

3/29 dily 385 15" 368

4/5 " 861

4/12 " 1400 12" 860

4/19 " 1960

4/26 " 2585 10" 2450

5/3 " 3060 2177 3050

5/10 7" 3193 5" 3263

Siliceous 3277 T D 3280

1500' oil P.B.P.

5/16 Siliceous 3277 T D 3280

1002 Bbls.

COMPLETED

Map No. 72 Sec. 22 Twp. 13 R. 14WWell No. 1-WalkTom Palmer Company

Contractor

FIRST REPORTS

Ft. from N. Line

330 Ft. from S. Line

Ft. from E. Line

330 Ft. from W. Line

SECTION PLAT

0			

Location

Rig up

Drilling and Remarks:

Bedg Rig

RECORD

Cased in., ft.

Sand

Gas

Oil

Total Depth

PRODUCTION

1st 24 hrs. Nat.

1st 24 hrs. after shot

Gas⁺ Cu. Ft.

Dry Hole

Abandoned

Date

3-7-34 192 O. Marmuehuck Scout

KANSAS

Map No. 77 Sec. 22 Twp. 13 R. 14WWell No. 1-WaelkTom Palmer

Company

Contractor

COMPLETED

SECTION PLAT

____ Ft. from N. Line

330 Ft. from S. Line

____ Ft. from E. Line

330 Ft. from W. Line

Location _____

Rig up _____

Drilling and Remarks:

1002 lbs

RECORD

Cased _____ in., _____ ft.

Sand silicious 3277

Gas _____

Oil _____

Total Depth 3280

PRODUCTION

1st 24 hrs. Nat. _____

1st 24 hrs. after shot _____

Gas _____ Cu. Ft.

Dry Hole _____

Abandoned _____

Date

5-16-34

19

ORVAL MANNSCHRECK

Scout