

# KANSAS


FORM 51 5M PETROL

Barton

Section 24 Township 16 Range 12-W

Well No. #3-P. Dolecheck

Company Black-Marshall

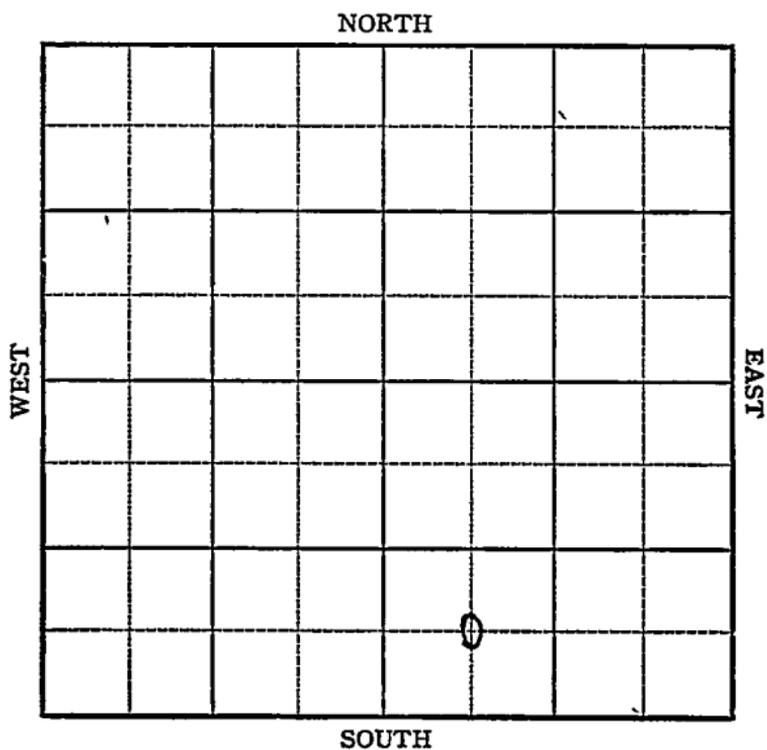

KANSAS

Barton

Sec. 24 Twp. 16 R. 12-W


Well No. #3 P. Dolecheck Farm  
Black-Marshall Company

         Ft. from N. Line

660 Ft. from S. Line

         Ft. from E. Line

660 Ft. from W. Line

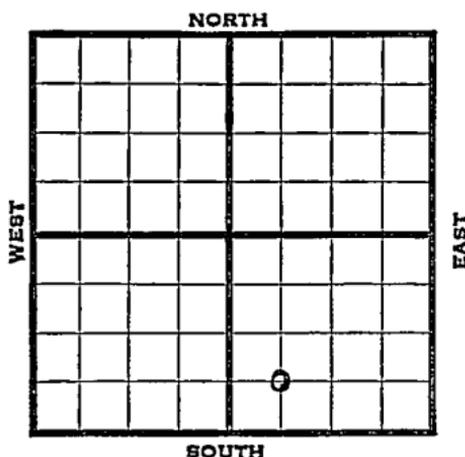

*ELEY, 1906*

1943	REPORT
9/1	Location
9/8	Cable rig
9/15	" "
9/22	12" @ 446 Drlg. 715'
9/29	10" @ 768' Drlg. 1750'
10/6	8" @ 2104' Drlg. 2460'
10/13	Drlg. 2695 8" @ 2452
10/20	Lans 3090 Drlg. 3245'
10/27	" "
11/3	BKC 3350 Sand 3366-72 5" @ 3366
	75% oil 11 12 hrs.
11/10	" "
11/17	" " "

**OVER**

1943

11/24 BKG 3350 sd 3366-72

5" @ 3366 75 oil

12/1

"

"

12/8

"

"

12/15

5" @ 3366

Sand 3366

Pump 85 Pot.

TD 3372

Gravi 36.8

COMPLETED

KANSAS  
Map No. 55 Sec. 24 Twp. 16 R. 12W

Well No. 3 P. Dolecheck

Black-Marshall Company

FIRST REPORT Contractor

C SW SE

SECTION PLAT

\_\_\_\_\_ Ft. from N. Line

660 Ft. from S. Line

\_\_\_\_\_ Ft. from E. Line

660 Ft. from W. Line

		o	

Beaver Pool

Location X

Rig up \_\_\_\_\_

Drilling and Remarks:

RECORD

Cased \_\_\_\_\_ in., \_\_\_\_\_ ft.

Sand \_\_\_\_\_

Gas \_\_\_\_\_

Oil \_\_\_\_\_

Total Depth \_\_\_\_\_

PRODUCTION

1st 24 hrs. Nat. \_\_\_\_\_

1st 24 hrs. after shot \_\_\_\_\_

Gas \_\_\_\_\_ Cu. Ft.

Dry Hole \_\_\_\_\_

Abandoned \_\_\_\_\_

Date

9/1 - 3

19

S. J. LEWIS Scout

KANSAS

Map No. 57 Sec. 24 Twp. 16 R. 12W

Well No. 3 P. Dolecheck

Black-Marshall Company

COMPLETED

Contractor

C SW SE

SECTION PLAT

		6	

         Ft. from N. Line

660 Ft. from S. Line

         Ft. from E. Line

660 Ft. from W. Line

Beaver Pool

Location                                 

Rig up                                 

Drilling and Remarks:

*Sand 3866  
5" 3366  
Pump 85 P.D.*

*36 5/16"*

RECORD

Cased          in.,          ft.

Sand                                 

Gas                                 

Oil                                 

Total Depth 3872

PRODUCTION

1st 24 hrs. Nat.                         

1st 24 hrs. after shot                         

Gas                          Cu. Ft.

Dry Hole                         

Abandoned                         

Date

DEC 15 1943 19

S. J. LEWIS Scout