


Section 24 Township 16 Range 12-W

Well No. #9, P. Dolecheck

Company Black-Marshall

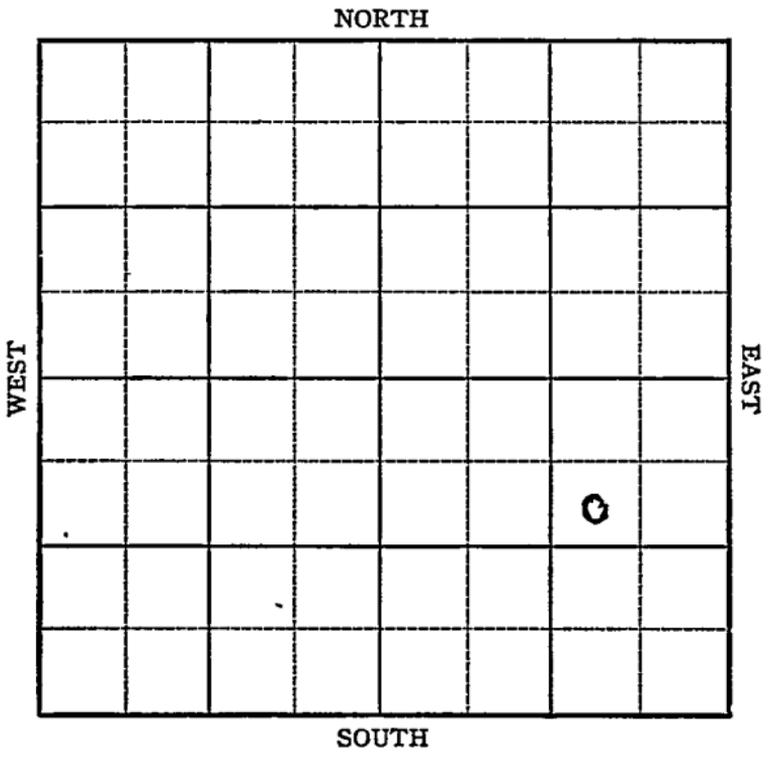

KANSAS

Barton County

Sec. 24 Twp. 16 R. 12W

Well No. #9 B. Dolecheck Farm

Black-Marshall Company

Kraft-Prusa


990 Ft. from N. Line

_____ Ft. from S. Line

_____ Ft. from E. Line

990 Ft. from W. Line

~~SW NE SE~~
~~SE NW SE~~

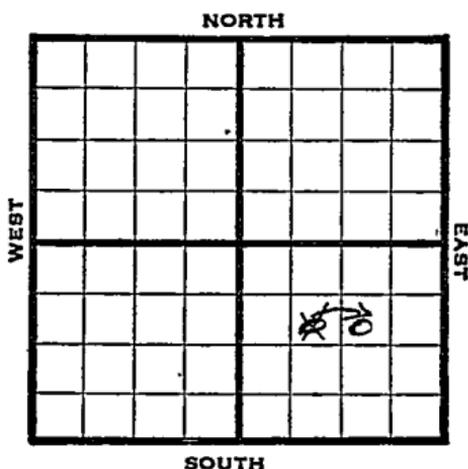

1946 REPORT
Elev. 1915

9/25	Location
10/1	"
10/8	"
10/15	"
10/22	"
10/29	"
11/6	"
11/12	"
11/20	"
11/27	"
12/3	"
12/10	"
12/17	"

1947

1/4	Location
1/8	"
1/15	"
1/21	"
1/30	8" @ 280 Anhydrite 770 Drlg 2350'

OVER

2/5 Lans 3074
 Sand 3349-51
 TD 3351'
 5" @ 3350'
 RUST

2/12 " " "

2/19 " " "

2/26 Gorham 3349
 5" @ 3350
 Pump 302 Pot
 Gray. 42
 TD 3362'

COMPLETED

KANSAS Kansas Pool Name Kraft-Prusa
 Map No. JS Sec. 24 Twp. 16 R. 12W
 Well No. 9 P. Dolecheck

Black-Marshall Company

FIRST REPORT Contractor

SE NW SE

SECTION PLAT

990 Ft. from N. Line

_____ Ft. from S. Line

_____ Ft. from E. Line

990 Ft. from W. Line

		2	

Barton County

Location X

Rig up _____

Drilling and Remarks:

RECORD

Cased _____ in., _____ ft.

Sand _____

Gas _____

Oil _____

Total Depth _____

PRODUCTION

1st 24 hrs. Nat. _____

1st 24 hrs. after shot _____

Gas _____ Cu. Ft.

Dry Hole _____

Abandoned _____

Date

SEP 25 1946 19

S. J. LEWIS Scout

11

Map No. 55 Sec. 24 Twp. 16 R. 12W

Well No. 9 P. Dolecheck

Black-Marshall

Company

CORRECTION

Contractor

SW NE SE

SECTION PLAT

990 Ft. from N. Line

_____ Ft. from S. Line

990 Ft. from E. Line

_____ Ft. from W. Line

	1		
			0

Barton County

Location _____

Rig up _____

Drilling and Remarks:

Reported

SE NW SE

RECORD

Cased _____ in., _____ ft.

Sand _____

Gas _____

Oil _____

Total Depth _____

PRODUCTION

1st 24 hrs. Nat. _____

1st 24 hrs. after shot _____

Gas _____ Cu. Ft.

Dry Hole _____

Abandoned _____

Date

OCT 9 1946 19

S. J. LEWIS Scout

