

Barton county


FORM 51 5M 6-46 PETROL

KANSAS

Section 24 Township 16 Range 12-W

Well No. #7, P. Dolecheck


Company Black-Marshall

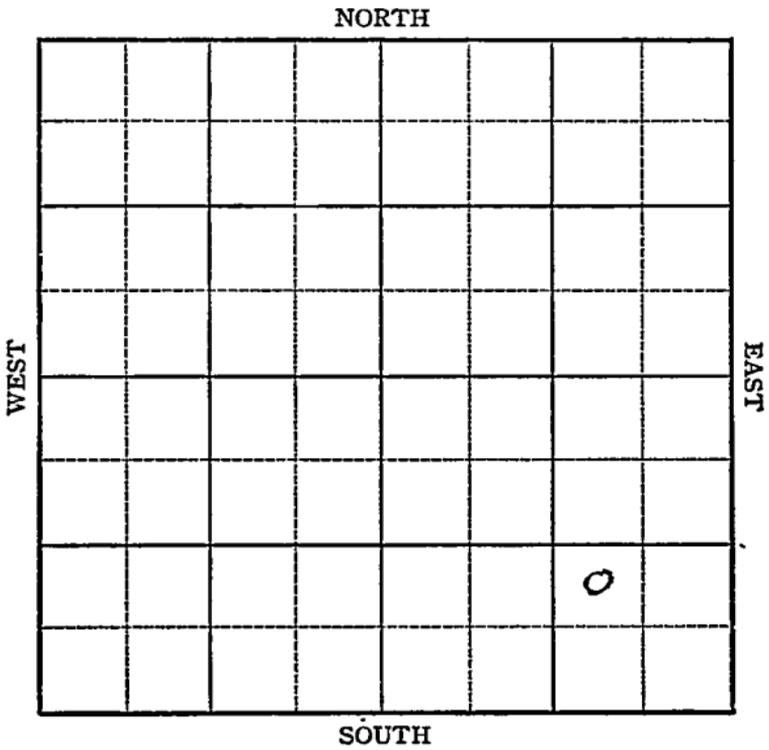

Sec. 24 Twp. 16-S R. 12-W

Well No. #7 P. Dolecheck Farm
Black-Marshall Company

_____ Ft. from N. Line
990' Ft. from S. Line
990' Ft. from E. Line
_____ Ft. from W. Line

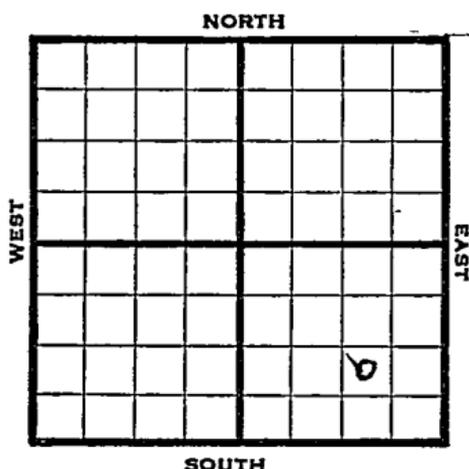

NW SE SE

1946

1921--

REPORT

- 9/5 Location
- 9/10 8" @ 264
Anhy 770'
Drlg 3178'
- 9/18 Lans 3082
Gorham 3 354
TD3356
5" @ 3354'
RUST
- 9/24 TD3367'
Swb 10 oil PH
- 10/2 Gorham 3354'
5" @ 3354'
TD 3367'
Pump 361 POT
Grav 42

COMPLETED

Kansas Pool Name

Map No. **KANSAS** Sec. 24 Twp. 16 R. 12W

Well No. 7 P. Dolecheck

Black-Marshall

Company

FIRST REPORT

Contractor

NW SE SE

SECTION PLAT

		.	
			o

_____ Ft. from N. Line

990 _____ Ft. from S. Line

990 _____ Ft. from E. Line

_____ Ft. from W. Line

Barton County

RECORD

Location **X**

Cased _____ in., _____ ft.

Rig up _____

Sand _____

Drilling and Remarks:

Gas _____

Oil _____

Total Depth _____

PRODUCTION

1st 24 hrs. Nat. _____

1st 24 hrs. after shot _____

Gas _____ Cu. Ft.

Dry Hole _____

Abandoned _____

Date

SEP 5 1946 19

S. J. LEWIS Scout

KA

Kansas Pool Name Kraft-Prusa Pool

Map No. 55 Sec. 24 Twp. 16 R. 12W

Well No. 7 P. Dolecheck

Black-Marshall Company

COMPLETED

Contractor

NW SE SE

E. 11921
SECTION PLAT

_____ Ft. from N. Line

990 Ft. from S. Line

990 Ft. from E. Line

_____ Ft. from W. Line

			0

Barton County

Location _____

Rig up _____

Drilling and Remarks:

Go down 3254

5" @ 3254

Pump 361 Pst

42 2/3

RECORD

Cased _____ in., _____ ft.

Sand _____

Gas _____

Oil _____

Total Depth 3367

PRODUCTION

1st 24 hrs. Nat. _____

1st 24 hrs. after shot _____

Gas _____ Cu. Ft.

Dry Hole _____

Abandoned _____

Date

OCT 2 1946 19

S. J. LEWIS Scout