


Section 23 Township 13 Range 14W

Well No. #3 Dumler

Company Lewis Mai

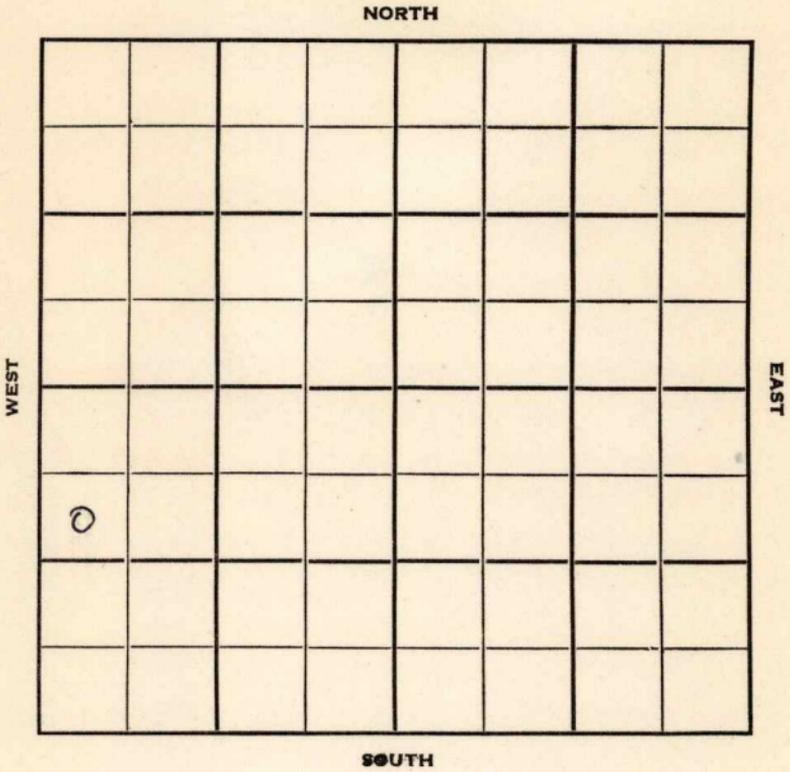

Russell

KANSAS

Sec. 23 Twp. 13 R. 14 W

Well No. # 3 Dumler Farm

Lewis Mai Company

Mai Contractor


990 NE Russell Pool  
Ft. from N. Line

Ft. from S. Line

Ft. from E. Line

330 Ft. from W. Line

SW NW SW

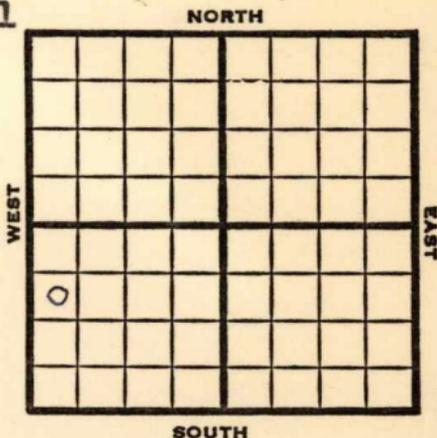

1951

Elev. 1844' REPORT

5/9

R U R

10/31

Spud 7-26-51  
 Oil Well TD 3318  
 15" @ 365 12" @ 462  
 Anhy 859  
 10" @ 852  
 Tarkio 2418  
 8" @ 2450  
 Top. 2650 KC 3000  
 7" @ 3020  
 Cong. 3288-91 Arb. 3302  
 TD 3318  
 5" @ 3304 FU 900' oil 36 hr.  
 Comp. 25 BOPD

**COMPLETED**



