

Russell


KANSAS

FORM 51 25M 3-49 PETROL

Section 23 Township 13 Range 14W

Well No. #4 Dumler

Company Lewis Mai

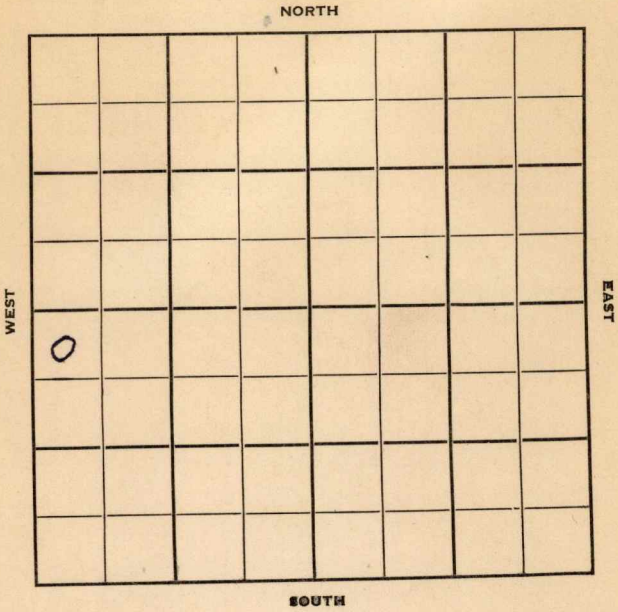

Russell

KANSAS

Sec. 23 Twp. 13 R. 14W

Well No. #4 Dumler Farm

Lewis Mai Company

Russell Pool Contractor


330 Ft. from N. Line

\_\_\_\_\_ Ft. from S. Line

\_\_\_\_\_ Ft. from E. Line

330 Ft. from W. Line

NW NW SW

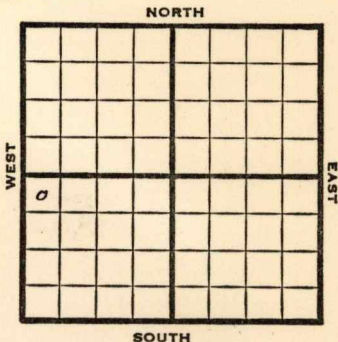

1951 **Elev. 1846'** REPORT

10/24 Spud 10-10-51  
 15" @ 354 12" @ 542  
**Anhy 859**  
 10" @ 865'  
 Drlg. 898'

1952  
 1/30 Spud 10-10-51  
 D&A TD 3327  
 15" @ 354 12" @ 542'  
**Anhy 859 10" @ 965 Tarkio 2398**  
**Top. 2655 Lans. 2995**  
 8" @ 2520 7" @ 3044 TD 3130  
 DD 3290 500 A B/ 13 BO 9 GW 18 hr.  
 DD 3291 wtr. CO to 3327 HFW  
 PB 3300 500 A wtr. 1000 A wtr.  
 D&A

**ABANDONED**



