


Section 23 Township 13 Range 14W

Well No. #5 Dumler

Company Lewis Mai

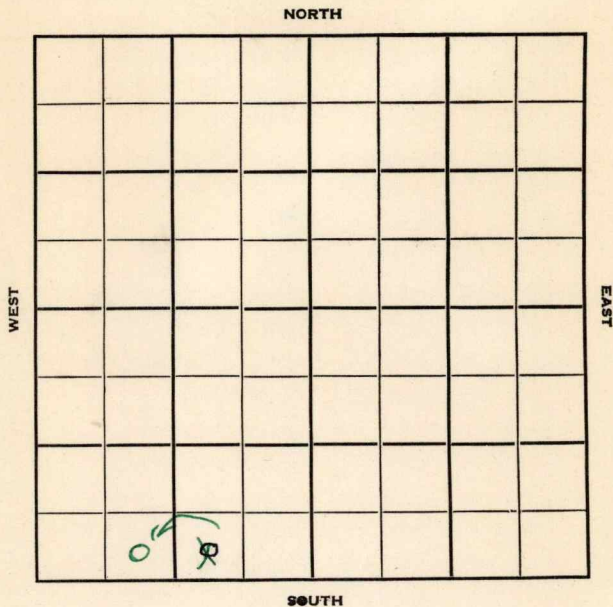

Russell KANSAS

Sec. 23 Twp. 13 R. 14 W

Well No. # 5 Dumlér Farm

Lewis Mai

Company

Lewis Mai

Contractor

Russell

Ft. from N. Line


330 Ft. from S. Line

990 Ft. from E. Line

990 Ft. from W. Line

~~SW SE SW~~

SE SW SW

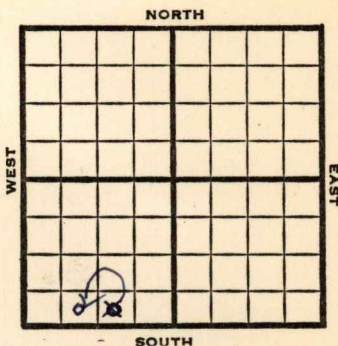

1952

Elev. 1845'

REPORT

1/9	Location	
2/6	B	
2/13	"	
2/20	"	
3/5	"	
3/12	"	
3/19	8" @ 197	
	Anhy 745-95	
	Drlg. 2079'	
3/25	Heeb. 2932	Lans. 2987
	Arb. 3270	RTD 3272
	5" @ 3271	
4/1	RUST	
4/9	Spud 3-12-52	
	Oil Well Td 3282'	
	8" @ 197 Anhy 745-95 Heeb. 2932	
	Lans. 2987 Arb. 3270	
	TD 3272 5" @ 3271 DD 3278	
	DD 3281 B/ 36 goph DD 3282	
	B/ 72 goph 500 A S/ 6 boph	
	Comp. 50 bopd	

COMPLETED

County Russell State Kansas

Sec. **23** (Blk. Twp.) **13** (Sur. Rge.) **14W** Map No.

Operator Lewis Mai

Well No. 5 Farm Dumlér

Elev.	1845	Location	SW SE SW
-------	------	----------	----------

FIRST REPORT

330 Ft. From S Line SW

990 Ft. From **E** Line Quarter

1st. Report JAN 9 1952

Completion

Remarks

Lewis Mai - Contr.

Spudding Date _____

Drlg. Data **Russell**

Location

J. E. TYRA

Kansas

Map No. _____ Sec. 23 Twp. 13 R. 14W

Well No. 5 Dumler

Lewis Mai Company

CORRECTION Contractor

SE SW SW

SECTION PLAT

_____ Ft. from N. Line

330 Ft. from S. Line

_____ Ft. from E. Line

990 Ft. from W. Line

0			

Russell County

Location _____

Rig up _____

Drilling and Remarks:

Reported

SW SE SW

RECORD

Cased _____ in., _____ ft.

Sand _____

Gas _____

Oil _____

Total Depth _____

PRODUCTION

1st 24 hrs. Nat. _____

1st 24 hrs. after shot _____

Gas _____ Cu. Ft.

Dry Hole _____

Abandoned _____

Date

MAR 19 1952

19

J. G. McGEHEE

Scout

County	Russell		State	Kansas
Sec.	23	(Blk. Twp.) 13	(Sur. Rge.) 14W	Map No.

Sec. 23 (Blk.) 13 (Sur.) 14 W Map No.

Operator Lewis Mai

Well No. 5 Farm Dumler

Elev.	1842	Location	SE SW SW
-------	------	----------	----------

330 Ft. From S Line SW

990 Ft. From W Line Quarter

1st. Report

Completion APR 9 1952

Remarks	Russell Pool
---------	--------------

Lewis Mai - Contr.

Spudding Date 3-12-52

Drilg. Data Oil well TD 3282

8" @ 197 Anhy 745-95 Heeb. 2932

Lans. 2987 Arb. 3270 TD 3272

5" @ 3271 DD 3278 DD 3281 B/ 36 goph

DD 3282 B/ 72 goph 500 A S/ 6 boph

Comp. 50 bopd

J. G. McGEHEE