
FORM 51 25M 8-50 WESTERN Russell KANSAS

Section 23 Township 13 Range 14W

Well No. #6 Dumler

Company Lewis Mai

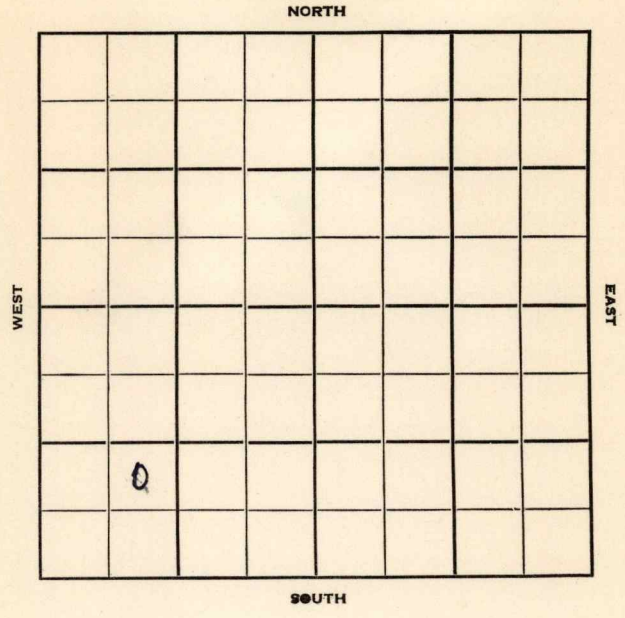

FORM 252-B
10M 10-50 PETROL

Russell

KANSAS

Sec. 23 Twp. 13 R. 14W

Well No. #6 Dumler Farm

Lewis Mai Company

B & R Drlg. Contractor

Russell Pool


____ Ft. from N. Line

990 Ft. from S. Line

____ Ft. from E. Line

990 Ft. from W. Line

NE SW SW

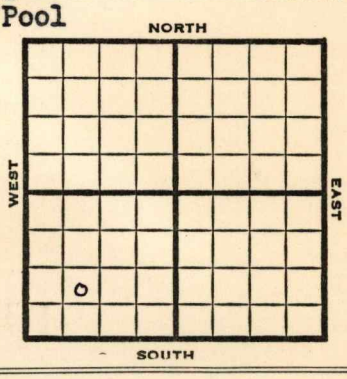

1952	Elev. 1846' REPORT
1/2	Spud 12-20-51 8" @ 208' Drlg. 2575'
1/23	Spud 12-20-51 Oil well TD 3285' 8" @ 208' Anhy 865' Lans. 2995' Arb. 3270-72 5" @ 3272' TD 3285' S/4 BOPH Comp. 50 BOPD COMPLETED

FORM 275 FOR SALE BY KANSAS BLUE PRINT CO.


County Russell State Kansas

Sec. 23 (Blk. / Twp.) ~~14~~ 13 (Sur. / Rge.) 14W Map No.

Operator Lewis Mai

Well No. 6 Farm Dumler

Elev. Location NE SW SW

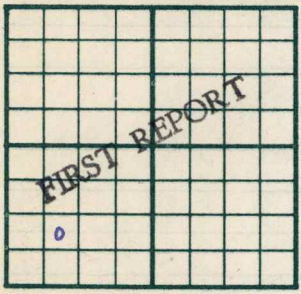

990 Ft. From S Line SW

990 Ft. From W Line Quarter

1st. Report JAN 2 1952

Completion

Remarks B & R Drlg. - Contr.

Spudding Date 12-20-51

Drlg. Data Russell Pool

8" @ 208 drlg. 2575

J. E. TYRA

FORM 275 FOR SALE BY KANSAS BLUE PRINT CO.


County Russell State Kansas

Sec. 23 (Blk. Twp.) 13 (Sur. Rge.) 14W Map No.

Operator Lewis Mai

Well No. 6 Farm Dumler

Elev. 1846 Location NE SW SW

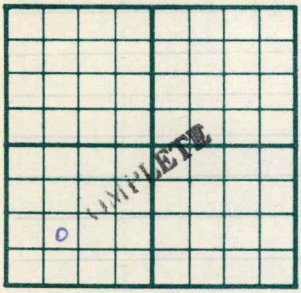

990 Ft. From S Line SW

990 Ft. From W Line Quarter

1st. Report

Completion JAN 23 1952

Remarks Russell Pool

B & R Drlg. - Contr.

Spudding Date 12-20-51

Drlg. Data Oil well TD 3285

8" @ 208 Anhy 865 Lans. 2995

Arb. 3270-72 5" @ 3272 TD 3285

S/ 4 boph Comp. 50 bopd

J. G. McGEHEE