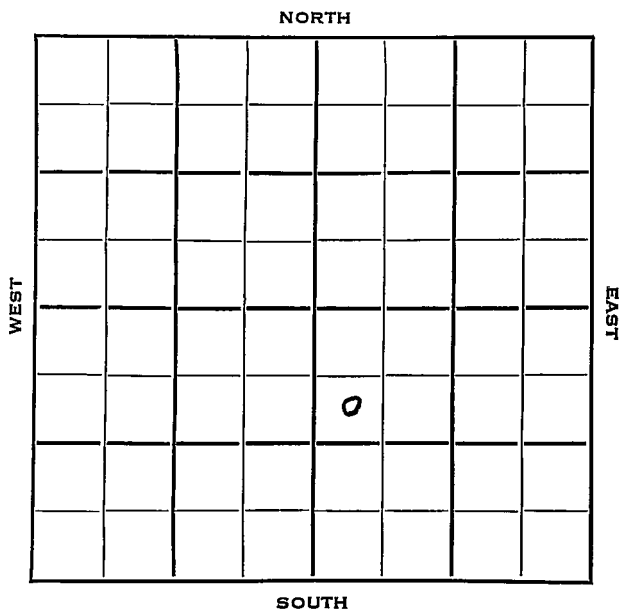


Section 24 Township 16 Range 12 WWell No. # 13 Paul DolechekCompany N C R A

Barton

KANSAS ✓

Sec. 24 Twp. 16 R. 12WWell No. #13 Paul Dolecheck FarmN C R A

Company

Lindas

Contractor

990

Ft. from N. Line


Ft. from S. Line

Ft. from E. Line

330

Ft. from W. Line

SW NW SE

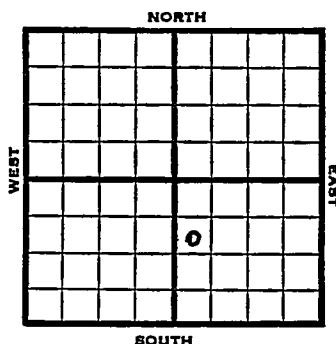

1953 Elev. 1896'

REPORT

4/15

RUR

4/23

8" @ 280 Anhy 770'

Drlg. 2805'

4/30

NR

5/7

5" @ 3371'

5/13

Spud 4-13-53

Oil Well

TD 3372'

8" @ 280'

Anhy 770, Lans 3071,

DST 3236-46 opn 2 hr, rec 30' mud, 0#

Cong 3326,

DST 3330-53 opn 2 hr, rec 2210' gas,

60' hocm, 780' oil, 25' sw. 350#

DST 3346-54 opn 2 hr, rec 12' mud

DST 3352-68 opn 2 hr, rec 750' sw 570#

TD 3372'

5" @ 3371'

CO to 3356' 3/ 3332-33 3/ 3333-34


FU 800' oil 1½ hr. 24/ 3334-38

6/ 3332-34 FU 1140' oil 2-3/4 hr.

S/ 13½ boph 3 hr.

Comp. 292 bopd.

COMPLETED

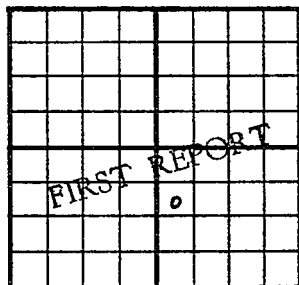County Barton State KansasSec. 24 (Blk.
Twp.) 16 (Sur.
Rge.) 12W Map No.Operator N C R AWell No. 13 Farm Paul DolecheckElev. Location SW NW SE990 Ft. From N Line SE330 Ft. From W Line Quarter1st. Report APR 15 1953

Completion

Remarks

Lindas - Contr.


Spudding Date

Drlg. Data

R U R

J. G. McGEHEE

County Barton State Kansas
 Sec. 24 (Blk.) 16 (Sur.) 12W Map No.
 Operator N C R A
 Well No. 13 Farm Paul Dolecheck
 Elev. 1896 Location SW NW SE

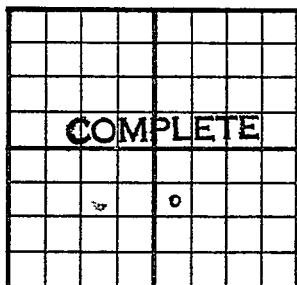

990 Ft. From N Line SE
330 Ft. From W Line Quarter

1st. Report

Completion MAY 13 1953

Remarks

Lindas - Contr.

Spudding Date 4-13-53

Drlg. Data Oil well TD 3372
8" @ 280 Anhy 770 Lans. 3071
DST 3236-46 open 2 hr. Rec. 30' mud
0# Cong. 3326 DST 3330-53 open 2 hr.
Rec. 2210' gas 60' hocm 780' oil
25' sw 350# DST 3346-54 open 2 hr.
Rec. 12' mud DST 3352-68 open 2 hr.
Rec. 750' sw 570# TD 3372 5" @ 3371
CO to 3356 3/ 3332-33 3/ 3333-34
FU 800' oil 1½ hr. 24/ 3334-38
6/ 3332-34 FU 1140' oil 2 3/4 hr.
S/ 13½ boph 3 hr.
Comp. 292 bopd

J. G. McGEHEE