


Section 23 Township 13 Range 14^W

Well No. #7 Dunler

Company Lewis Mai

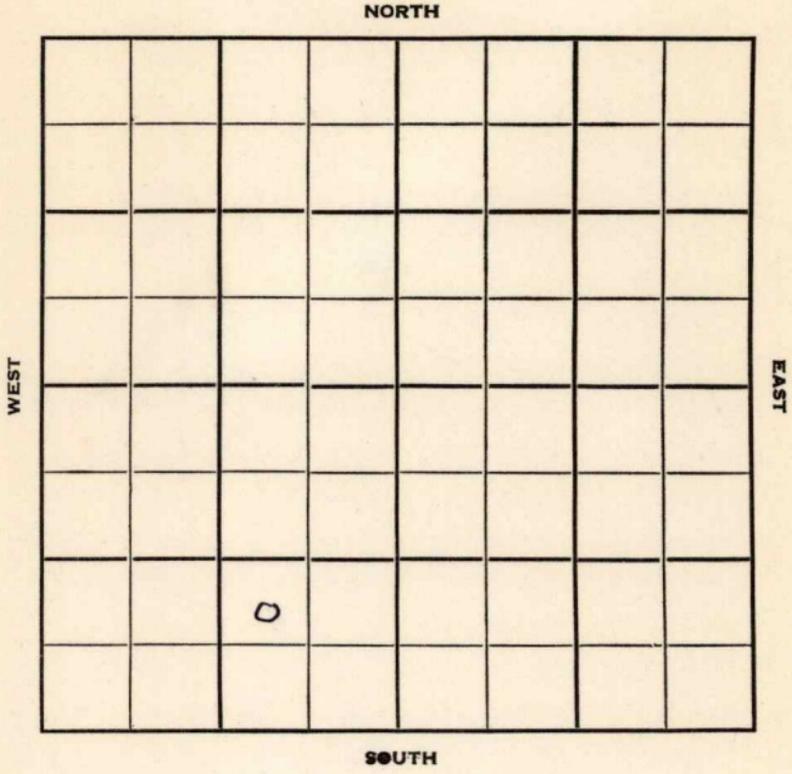

Russell KANSAS

Sec. 23 Twp. 13 R. 14 W

Well No. # 7 Dumler Farm

Lewis Mai Company

Contractor


Ft. from N. Line

990 Ft. from S. Line

990 Ft. from E. Line

Ft. from W. Line

NW SE SW

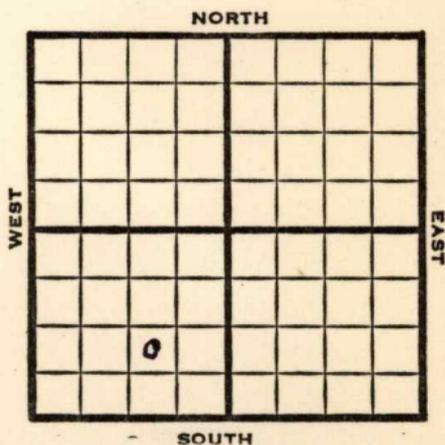

1952

Elev. 1846' REPORT

1/9

Spud 1-3-52
8" @ 195'
Anhy 865'
Drlg. 1856'

1/23

Spud 1-3-52
Oil well TD 3289' 8" @ 195'
Anhy 865' Arb. 3278-79'
5" @ 3278' TD 3289' 500 A
S/10 BOPH
Comp. 50 BOPD

COMPLETED

