

Section 23 Township 13 Range 14W

Well No. #1 Dumler "C"

Company Lewis Mai

NORTH

0							

WEST

EAST

SOUTH

Russell

KANSAS

Sec. 23 Twp. 13 R. 14 W ✓

Well No. # 1 Dumler "C" Farm

Lewis Mai Company

Lewis Mai Contractor

Russell


_____ Ft. from N. Line

330 Ft. from S. Line

_____ Ft. from E. Line

330 Ft. from W. Line

SW SW NW

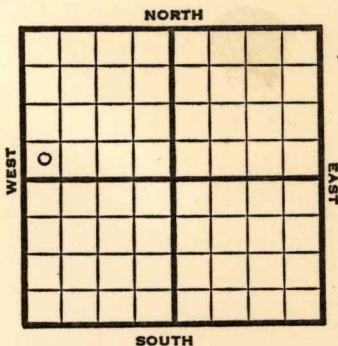

1951

Lev. 1846' REPORT

4/18
9/19

Location

Spud 5-9-51

Oil well TD 3298' 12" @ 530'

10" @ 862' **Tarkio 2408'**

8" @ 2450' **Top. 2643'** **KC 2987'**

HFW 3029-50 7" @ 3110' **Arb. 3279'**

TD 3284' 5" @ 3279' DD 3286'

10 GOPH 500 A no inc. DD 3298'

PB 3297' 1000 A S/15 BOPH 2 hr.

Comp. 75 BOPD

COMPLETED


County Russell State Kansas

Sec. 23 (Blk. 13) (Sur. 14W) Map No.

Operator Lewis Mai

Well No. 1 Farm Dumler "C"

Elev. 1846 Location SW SW NW

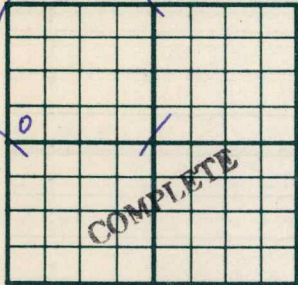

330 Ft. From S Line NW

330 Ft. From W Line Quarter

Ist. Report

Completion SEP 19 1951

Remarks Russell Pool

Lewis Mai - Contr.

Spudding Date 5-9-51

Drilg. Data Oil well TD 3298

12" @ 530 10" @ 862 Tarkio 2408

8" @ 2450 Top. 2643 KC 2987

HFW 3029-50 7" @ 3110 Arb. 3279

TD 3284 5" @ 3279 DD 3286 10 goph

500 A no inc. DD 3298 PB 3297

1000 A S/ 15 boph 2 hr.

Comp. 75 bopd

J. E. TYRA