

**KANSAS**

Russell

Section 25 Township 13 Range 14W


Well No. 2 Anschutz

Company R. Shields

Russell  
NORTH

WEST

EAST

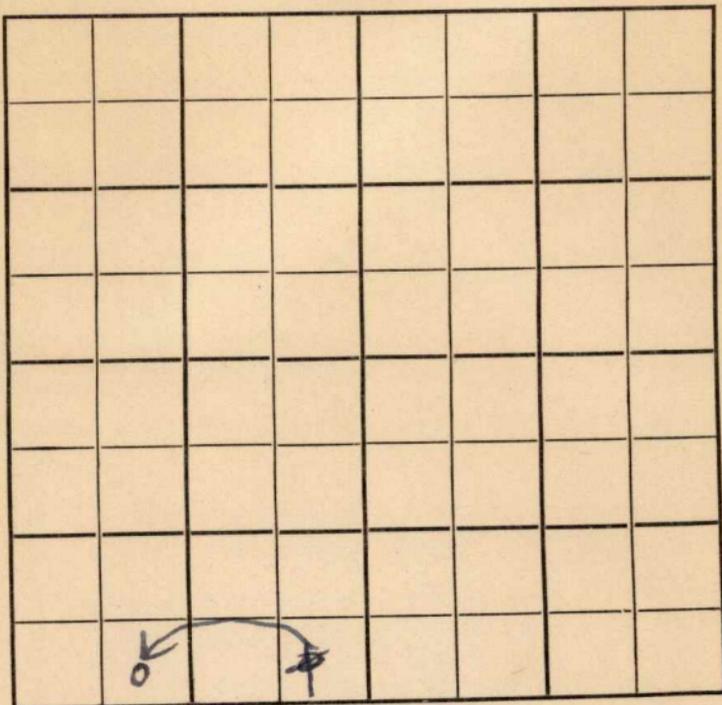

SOUTH

Russell **KANSAS** ✓

Sec. 25 Twp. 13 R. 14W

Well No. #2 Anschutz Farm

R. Shields Company


Russell Pool (Stearns Drlg., Cont.)

           Ft. from N. Line

330' Ft. from S. Line

330' Ft. from E. Line

990 Ft. from W. Line

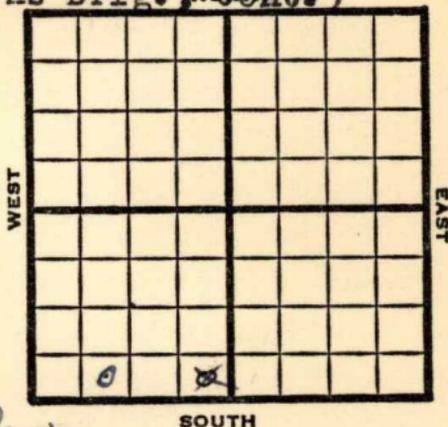

~~SE SW~~

*SE SW SW*

1949

**Elev 1825'**

REPORT

8/10

8" @ 120'

**Anhy. 823'**

Drlg. 900'

8/17

Drlg 3164'

8/24

**Lansing 2983**

**Arbuckle 3268**

TD 3278

5" @ 3269

8/31

TD 3282

Swb 30 bbls oil a day

9/7

"

9/14

TD 3282'

**Arb. 3268'**

5" @ 3271'

Pump 97 Oil Pot

37° Gr.

Comp

**COMPLETED**

Map No. \_\_\_\_\_ Sec. 25 Twp. 13 R. 14W

Well No. 2 Anschutz

R. Shields Company

Stearns Drlg. Contractor

SE SW

FIRST REPORT  
SECTION PLAT

\_\_\_\_\_ Ft. from N. Line

330 Ft. from S. Line

330 Ft. from E. Line

\_\_\_\_\_ Ft. from W. Line


Russell County

Location \_\_\_\_\_

Rig up \_\_\_\_\_

Drilling and Remarks:

8" @ 120

Anhy 823

drlg. 900

RECORD

Cased \_\_\_\_\_ in., \_\_\_\_\_ ft.

Sand \_\_\_\_\_

Gas \_\_\_\_\_

Oil \_\_\_\_\_

Total Depth \_\_\_\_\_

PRODUCTION

1st 24 hrs. Nat. \_\_\_\_\_

1st 24 hrs. after shot \_\_\_\_\_

Gas \_\_\_\_\_ Cu. Ft.

Dry Hole \_\_\_\_\_

Abandoned \_\_\_\_\_

Date

AUG 10 1949

19

S. J. LEWIS

Scout

Map No. \_\_\_\_\_ Sec. 25 Twp. 13 R. 14W


Well No. 2 Anschutz

R. Shields Company

CORRECTION Contractor

SE SW SW

SECTION PLAT

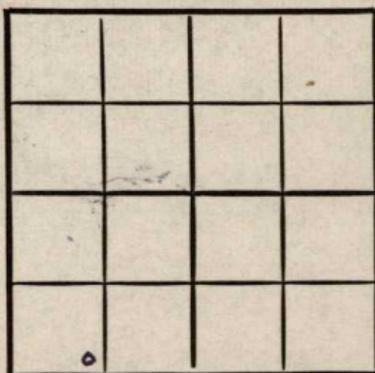

Ft. from N. Line

330 Ft. from S. Line

Ft. from E. Line

990 Ft. from W. Line

Russell County

RECORD

Location \_\_\_\_\_

Cased \_\_\_\_\_ in., \_\_\_\_\_ ft.

Rig up \_\_\_\_\_

Sand \_\_\_\_\_

Drilling and Remarks:

Gas \_\_\_\_\_

Oil \_\_\_\_\_

Reported

Total Depth \_\_\_\_\_

SE SW

PRODUCTION

1st 24 hrs. Nat. \_\_\_\_\_

1st 24 hrs. after shot \_\_\_\_\_

Gas \_\_\_\_\_ Cu. Ft.

Dry Hole \_\_\_\_\_

Abandoned \_\_\_\_\_

Date

AUG 24 1949 19

S. J. LEWIS Scout

Kansas

Map No. K 72 Sec. 25 Twp. 13 R. 14W

Well No. 2 Anschutz

R. Shields Company


**COMPLETE**

Contractor

SE SW SW

*E. 1825*

**SECTION PLAT**

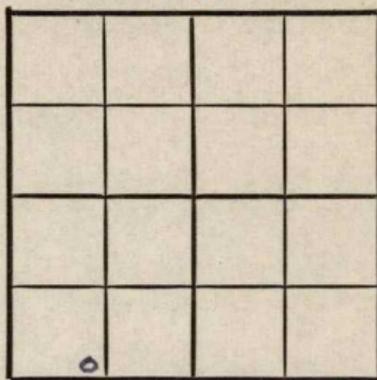

\_\_\_\_\_ Ft. from N. Line

330 Ft. from S. Line

\_\_\_\_\_ Ft. from E. Line

990 Ft. from W. Line

Russell County

Location \_\_\_\_\_

Rig up \_\_\_\_\_

Drilling and Remarks:

*CR 8268*

*5" C3271*

*Prod 97 oil Port.*

*3798*

**RECORD**

Cased \_\_\_\_\_ in., \_\_\_\_\_ ft.

Sand \_\_\_\_\_

Gas \_\_\_\_\_

Oil \_\_\_\_\_

Total Depth 3282

**PRODUCTION**

1st 24 hrs. Nat. \_\_\_\_\_

1st 24 hrs. after shot \_\_\_\_\_

Gas \_\_\_\_\_ Cu. Ft.

Dry Hole \_\_\_\_\_

Abandoned \_\_\_\_\_

Date

SEP 14 1949

19

S. J. LEWIS

Scout