


Section 24 Township 16 Range 12-W

Well No. 1 F. Dolechek

Company Gulf

NORTH Wildcat

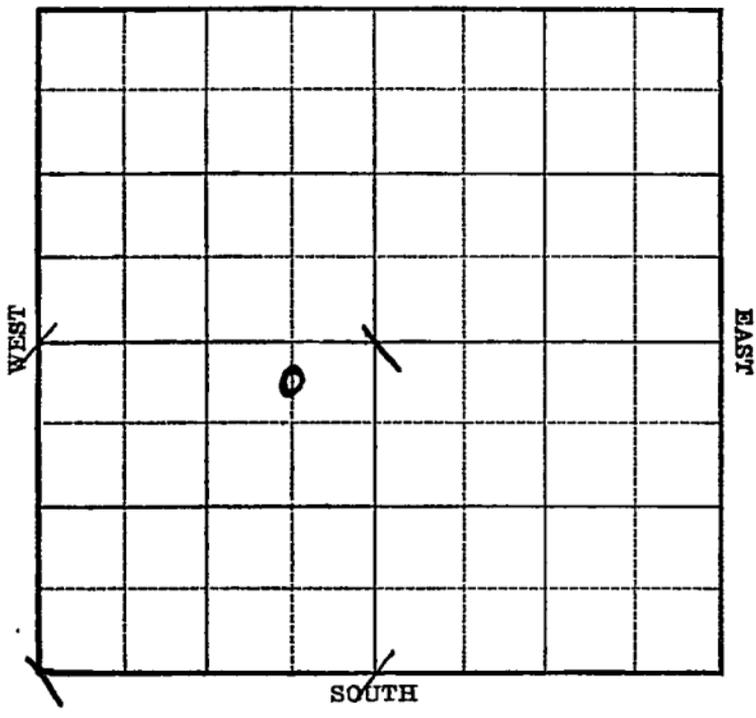

Sec. 24 Twp. 16 R. 12-WWell No. #1 F. Dolechek FarmGulf Company

(Wildcat)


330 Ft. from N. Line

\_\_\_\_\_ Ft. from S. Line

660 Ft. from E. Line

\_\_\_\_\_ Ft. from W. Line

Elev. 1901

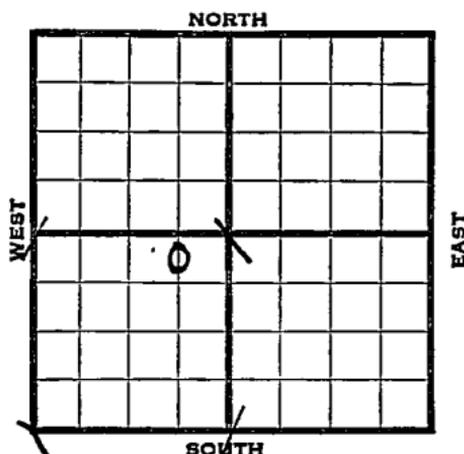

1939	REPORT
3/8	Cellar.
3/17	16" - 338' WOC.
3/24	Anhy 780' Drlg. 2510'
3/31	Topeka 2723' Lans. 3079'
	S.S.O. 3082-84' B.K.C. 3327'
	Cong. 3334' Drlg. 3348'
4/7	Quartzite 3380' T.D. 3400'
	No Oil. S.D.O.
4/14	8" - 3345' 2500' water in 15
	Min. Cementing 3" tubing at
	3363'
4/19	3" tubing cemented 3363'
	8" - 3345'
	Quartzite 3380'
	T. D. 3400' H.F.W.
	ABANDONED

Barton

KANSAS

Map No. 55 Sec. 24 Twp. 16 R. 12WWell No. 1 F. Dolechek

Gulf

Company

Contractor

**FIRST REPORT**

C N L NE SW


330 Ft. from N. Line

\_\_\_\_\_ Ft. from S. Line

660 Ft. from E. Line

\_\_\_\_\_ Ft. from W. Line

WILDCAT

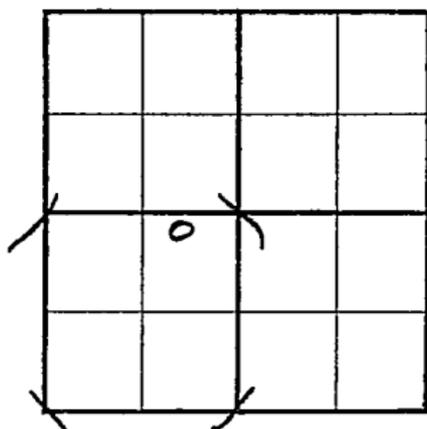**SECTION PLAT**

Location \_\_\_\_\_

Rig up \_\_\_\_\_

Drilling and Remarks:

Cellar

**RECORD**

Cased \_\_\_\_\_ in., \_\_\_\_\_ ft.

Sand \_\_\_\_\_

Gas \_\_\_\_\_

Oil \_\_\_\_\_

Total Depth \_\_\_\_\_

**PRODUCTION**

1st 24 hrs. Nat. \_\_\_\_\_

1st 24 hrs. after shot \_\_\_\_\_

Gas \_\_\_\_\_ Cu. Ft.

Dry Hole \_\_\_\_\_

Abandoned \_\_\_\_\_

Date

MAR 8 - 1939 19

H. D. Hatfield Scout

Map No. 55 Sec. 24 Twp. 16 R. 12WWell No. 1 F. DolechekGulf

Company

Contractor

## ABANDONED

C N L N E S W

330 Ft. from N. Line

\_\_\_\_\_ Ft. from S. Line

660 Ft. from E. Line

\_\_\_\_\_ Ft. from W. Line

## SECTION PLAT

	0		

## WILDCAT

Location \_\_\_\_\_

Rig up \_\_\_\_\_

Drilling and Remarks:

HFW

D &amp; A

3" Tubing Cem. 3363  
RECORDCased 8 in., 3345 ft.Sand Quartzite 3380

Gas \_\_\_\_\_

Oil \_\_\_\_\_

Total Depth 3400

## PRODUCTION

1st 24 hrs. Nat. \_\_\_\_\_

1st 24 hrs. after shot \_\_\_\_\_

Gas \_\_\_\_\_ Cu. Ft.

Dry Hole \_\_\_\_\_

Abandoned \_\_\_\_\_

Date

APR 19 1939

19

H. D. Hatfield Scout