

Section 24 Township 16 Range 12 WWell No. # 9 DolechekCompany N C R A

	0						

NORTH

WEST

EAST

SOUTH

Barton

KANSAS ✓

Sec. 24 Twp. 16 R. 12WWell No. #9 Dolechek Farm

N C R A

Company

Anschutz

Contractor

Kraft-Prusa Pool

Ft. from N. Line

330


Ft. from S. Line

Ft. from E. Line

990

Ft. from W. Line

SE SW SW

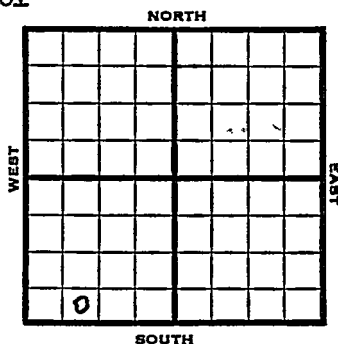

1953

Elev. 1906'

REPORT

7/22

Spud 7-17-53

8" @ 295

Anhy 772

Drlg. 1550'

7/29

Heeb 2975, Tor 2994, Doug 3007, Br li 3076, Lans 3087, Cong 3319

8/26

Spud 7-17-53 Oil well TD 3390

8" @ 295 Anhy 772 Heeb 2975

Tor. 2994 Doug. 3007 Br li 3076

Lans 3087 Cong 3319

DST 3337-47 open 2 hr rec 3300' gas, 160' HO & GCM, 125' MCO, 5' mud 430#

DST 3346-59 open 2 hr rec 1045' free oil, 480' frothy oil 540#

TD 3390 5" @ 3389 PB 3372

2/3332 21/3333-40 S/1 BOPH FU 430'

oil 15 hr. S/1 BOPH 4 hr. FU 738'

oil 44 hr. Hydro. FU 43 BO 15 hr.

CO to 3372 S/1 BOPH 2 hr. FU 369'


oil 15 hr. S/13 BO 3 hr. Hydro.

S/106 BO 3 hr.

Comp. 426 BOPD

COMPLETED

J. G. McQuillan

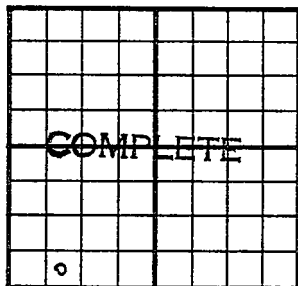County Barton State KansasSec. 24 (Blk.
Twp.) 16 (Sur.
Rge.) 12W Map No.Operator N C R AWell No. 9 Farm DolechekElev. 1906 Location SE SW SW330 Ft. From S Line SW990 Ft. From W Line Quarter1st. ReportCompletion AUG 26 1953Remarks Kraft-Prusa PoolAnschutz - Contr.Spudding Date 7-17-53Drlg. Data Oil well TD 33908" @ 295 Anhy 772 Heeb. 2975Tor. 2994 Doug. 3007 Br. lime 3076Lans. 3087 Cong. 3319 DST 3337-47open 2 hr. Rec. 3300' gas 160' ho & gcm125' mco 5' mud 430# DST 3346-59open 2 hr. Rec. 1045' free oil 480' frothyoil 540# TD 3390 5" @ 3389 PB 33722/ 3332 21/ 3333-40 S/ 1 boph FU 430'oil 15 hr. S/ 1 boph 4 hr. FU 738'oil 44 hr. Hydro. FU 43 b6 15hr.CO to 3372 S/ 1 boph 2 hr. FU 369' bil15 hr. S/ 13 bo 3 hr. Hydro.S/ 106 bo 3 hr. Comp. 426 bopd

J. G. McGEHEE