


Section 24 Township 16 Range 12W

Well No. #11 Dolchek (Dolechek)

Company N G RA

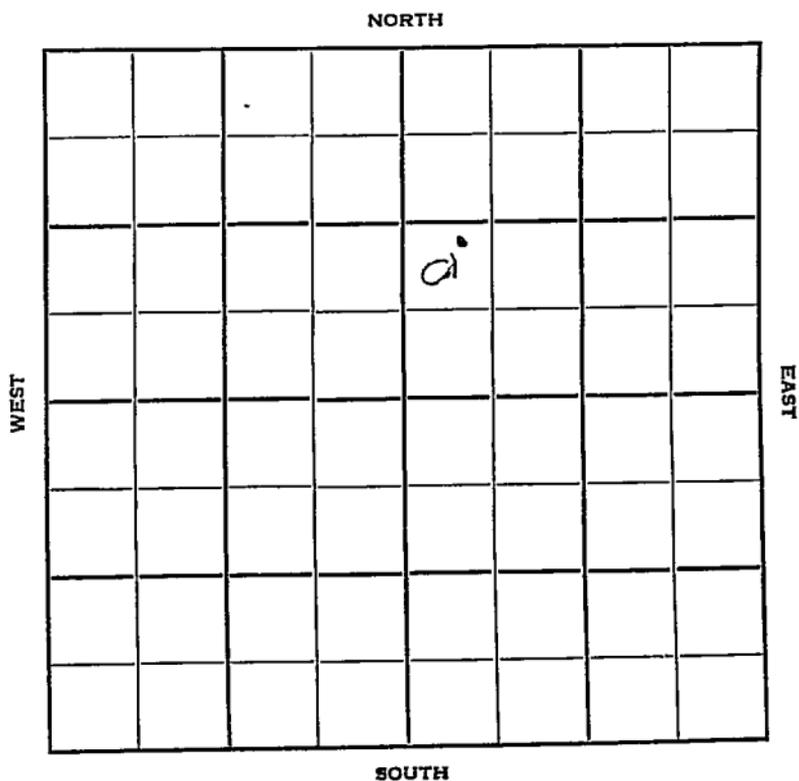

Sec. 24 Twp. 16 R. 12W ✓

Well No. #11 Dolechek Farm

NC RA Company

Contractor

Kraft-Prusa


Ft. from N. Line

990' Ft. from S. Line

Ft. from E. Line

330' Ft. from W. Line

NW SW NE

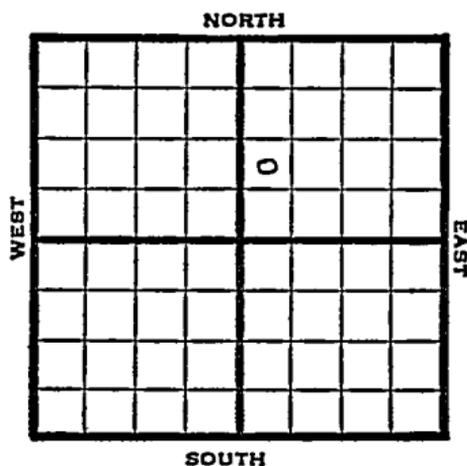

1950

Elev 1883' REPORT

1/25 Spud 1-19-50
10" @ 252'
Anhy 775'
Drlg. 1945'

2/1 TD 3391'
10"@ 252'
Heeb 2961'
Br L 3054'
Lans 3072'
Gong 3326'
DST 3348-91
Rec wtr.
D&A
Aband.

ABANDONED

Map No. _____ Sec. 24 Twp. 16 R. 12WWell No. 11 DolechekN C R A

Company _____

Contractor _____

NW SW NE

_____ Ft. from N. Line

990 Ft. from S. Line

_____ Ft. from E. Line

330 Ft. from W. Line

SECTION PLAT

Barton County

Location _____

Rig up _____

Drilling and Remarks:

Spud 1-19-50

10" @ 252

Anhv 775

drlg. 1945

RECORD

Cased _____ in., _____ ft.

Sand _____

Gas _____

Oil _____

Total Depth _____

PRODUCTION

1st 24 hrs. Nat. _____

1st 24 hrs. after shot _____

Gas _____ Cu. Ft.

Dry Hole _____

Abandoned _____

Date

JAN 25 195019J. E. TYRA Scout

Map No. _____ Sec. 24 Twp. 16 R. 12WWell No. 11 DolechekN C R A

Company _____

Contractor _____


NW SW NE

E. 1883
SECTION PLAT

_____ Ft. from N. Line

990 Ft. from S. Line

_____ Ft. from E. Line

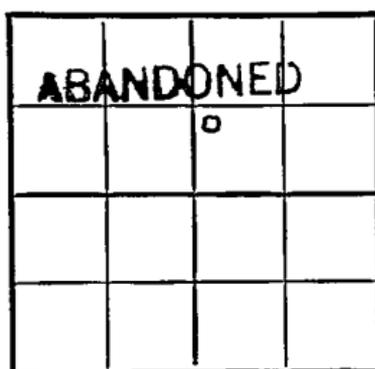330 Ft. from W. Line

Barton County

Location _____

Rig up _____

Drilling and Remarks:

10" @ 252
Heb 2961
Br. - 3054
Lans 3072
Comp 3326
DSPT 3348-91 nec
water D & A.

RECORD

Cased _____ in., _____ ft.

Sand _____

Gas _____

Oil _____

Total Depth 3391

PRODUCTION

1st 24 hrs. Nat. _____

1st 24 hrs. after shot _____

Gas _____ Cu. Ft.

Dry Hole _____

Abandoned _____

Date

FEB 1 1950 19J. E. TYRA Scout