


Section 24 Township 16 Range 12-W

Well No. #12 Dale Chek (Dolechek)

Company N C R A

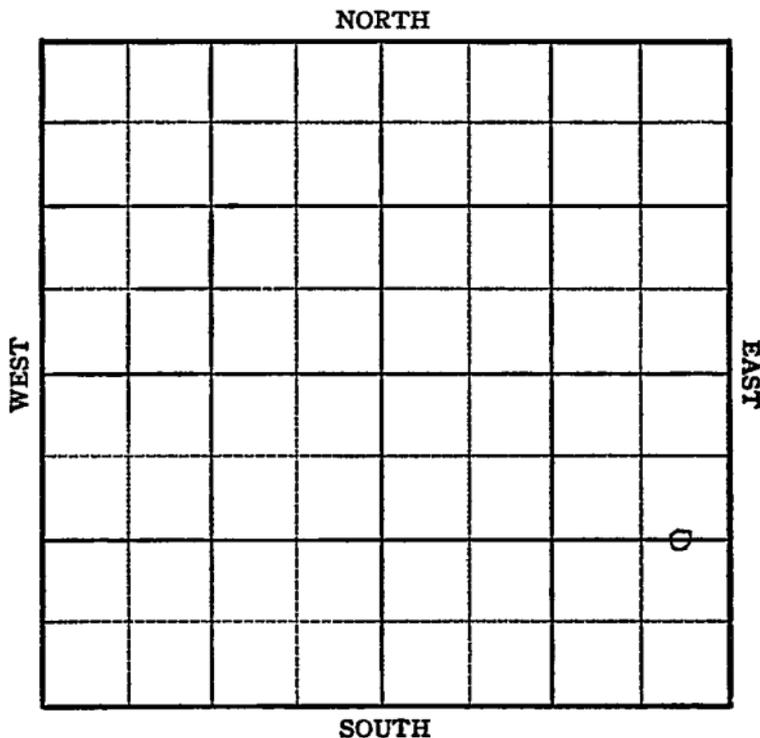

Barton

KANSAS

Sec. 24 Twp. 16 R. 12W ✓

Well No. #12 Dale Chek Farm

N C R A Company

Contractor

Kraft Prusa

Ft. from N. Line

1320'


Ft. from S. Line

330'

Ft. from E. Line

Ft. from W. Line

C E/2 E/2 SE

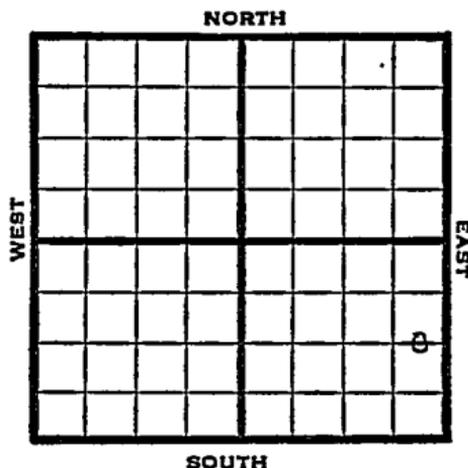

1950

Elev. 1912' REPORT

5/17

Spud 5-12-50  
8" @ 261' -  
Anhy. 765-96  
Drlg. 1660'

6/7

8" @ 261'  
KC 3084'  
Cong 3347'  
Sand 3381-84  
D&A TD 3384'

**ABANDONED**

Kansas

Map No. \_\_\_\_\_ Sec. 24 Twp. 16 R. 12<sup>W</sup>

Well No. 12 Dale Chek

N C R A \_\_\_\_\_ Company

\_\_\_\_\_ Contractor

C E/2 E/2 SE

## SECTION PLAT

\_\_\_\_\_ Ft. from N. Line

1320 Ft. from S. Line

330 Ft. from E. Line

\_\_\_\_\_ Ft. from W. Line



Barton

Location \_\_\_\_\_

Rig up \_\_\_\_\_

## Drilling and Remarks:

Spud 5-12-50

8" @ 261

Anhy. 765-96

Dr lg. 16'0

## RECORD

Cased \_\_\_\_\_ in., \_\_\_\_\_ ft.

Sand \_\_\_\_\_

Gas \_\_\_\_\_

Oil \_\_\_\_\_

Total Depth \_\_\_\_\_

## PRODUCTION

1st 24 hrs. Nat. \_\_\_\_\_

1st 24 hrs. after shot \_\_\_\_\_

Gas \_\_\_\_\_ Cu. Ft.

Dry Hole \_\_\_\_\_

Abandoned \_\_\_\_\_

Date

MAY 17 1950 19

J. E. TYRA

Scout

Kansas Kraft Prusa

Map No. \_\_\_\_\_ Sec. 24 \_\_\_\_\_ Twp. 16 \_\_\_\_\_ R. 12W \_\_\_\_\_

Well No. 12 Dolecheck \_\_\_\_\_

N C R A \_\_\_\_\_ Company \_\_\_\_\_

\_\_\_\_\_ Contractor \_\_\_\_\_

C E/2 E/2 SE

EL. 1912  
SECTION PLAT

\_\_\_\_\_ Ft. from N. Line

1320 Ft. from S. Line

330 Ft. from E. Line

\_\_\_\_\_ Ft. from W. Line



Barton

Location \_\_\_\_\_

Rig up \_\_\_\_\_

Drilling and Remarks:

8" @ 261  
 KC 3084  
 Cong 3347  
 Sand 3381-84  
 D & A

## RECORD

Cased \_\_\_\_\_ in., \_\_\_\_\_ ft.

Sand \_\_\_\_\_

Gas \_\_\_\_\_

Oil \_\_\_\_\_

Total Depth 3384

## PRODUCTION

1st 24 hrs. Nat. \_\_\_\_\_

1st 24 hrs. after shot \_\_\_\_\_

Gas \_\_\_\_\_ Cu. Ft.

Dry Hole \_\_\_\_\_

Abandoned \_\_\_\_\_

Date

JUN 7 1951 19 \_\_\_\_\_

J. E. TYRA Scout