


Section 26 Township 13 Range 14W

Well No. #2 Dumler

Company Lewis Drlg.

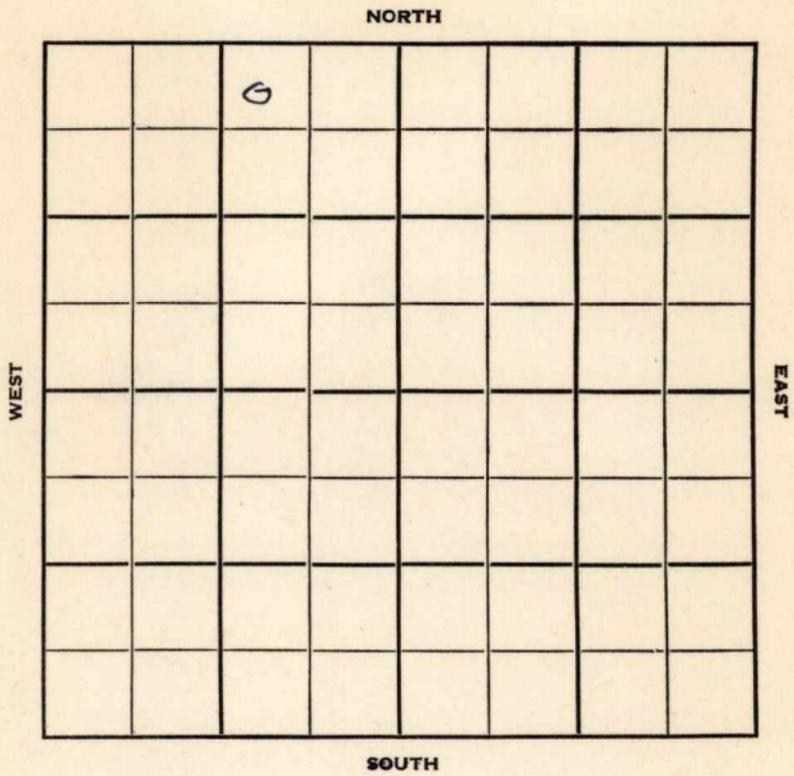

Russell

Sec. 26 Twp. 13 R. 14W

Well No. #2 Dumler Farm

Lewis Drlg. Company

Lewis Drlg. Contractor

Russell


330 Ft. from N. Line

Ft. from S. Line

990 Ft. from E. Line

Ft. from W. Line

NW NE NW

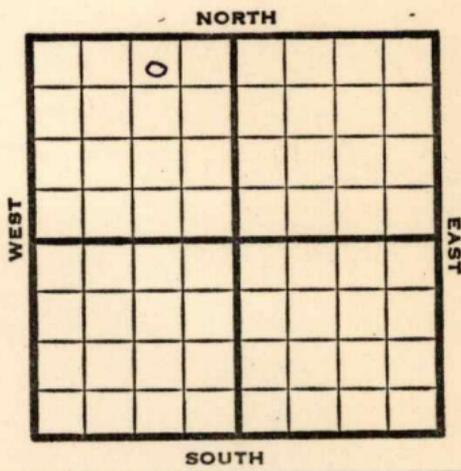

1952 **Elev. 1843'** REPORT

- 1/23 Spud 1-17-52
8" @ 301
Anhy 880'
Drlg. 1947'
- 2/6 TD 3291 5" @ 3285
B/ 88 BOPH for 8 hrs. 500 A
- 2/13 S/2 BOPH for 8 hrs DD 3297 TD
S 2 1/2 BOPH for 5 hrs POP
- 2/20 POP
- 3/5 No report
- 3/12 "
- 3/19 Spud 1-17-52
Oil Well TD 3297 8" @ 301
Anhy 880 **Heeb. 2944**
Tor. 2965 **Lans. 2999**
DST 3240-87 open 1 hr. rec. 10' OCM
Arb. 3284
DST 3235-91 open 1 hr. rec. 50' OCM
TD 3291 5" @ 3285 CO to 3290
B/ 88 boph 8 hr. 500 A S/ 2 boph
DD 3297 S/ 2 1/2 boph 5 hr.
Comp. 50 bopd

COMPLETED

County Russell State Kansas

Sec. 26 (Blk. 13 (Sur. 14W (Twp.) (Rge.) Map No.

Operator Lewis Drlg.

Well No. 2 Farm Dunler

Elev. 1843 Location NW NE NW

FIRST REPORT

330 Ft. From N Line NW

990 Ft. From E Line Quarter

1st. Report JAN 23 1952

Completion _____

Remarks _____

Lewis Drlg. - Contr.

Spudding Date 1-17-52

Drlg. Data Russell


8" @ 301 Anhy 880 Drlg. 1947

J. E. TYRA

County Russell State Kansas
 Sec. 26 (Blk. 13) (Sur. 14W) Map No. _____
 Operator Lewis Drlg.
 Well No. 2 Farm Dumler
 Elev. 1843 Location NW NE NW

330 Ft. From N Line NW
990 Ft. From E Line Quarter
 Ist. Report _____
 Completion MAR 19 1952
 Remarks Russell Pool
Lewis Drlg. - Contr.
 Spudding Date 1-17-52

Drlg. Data Oil well TD 3297
8" @ 301 Anhy 880 Heeb. 2944
Tor. 2965 Lans. 2999 DST 3240-87
open 1 hr. Rec. 10' ocm Arb. 3284
DST 3235-91 open 1 hr. Rec. 50' ocm
TD 3291 5" @ 3285 CO to 3290
B/ 88 boph 8 hr. 500 A S/ 2 boph
DD 3297 S/ 2 1/2 boph 5 hr.
Comp. 50 bopd

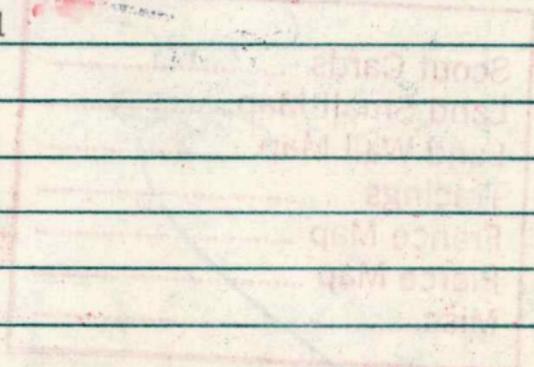

J. G. McGEHEE