


Section 26 Township 13 Range 14W

Well No. #1 Krug

Company G. W. Davis et al

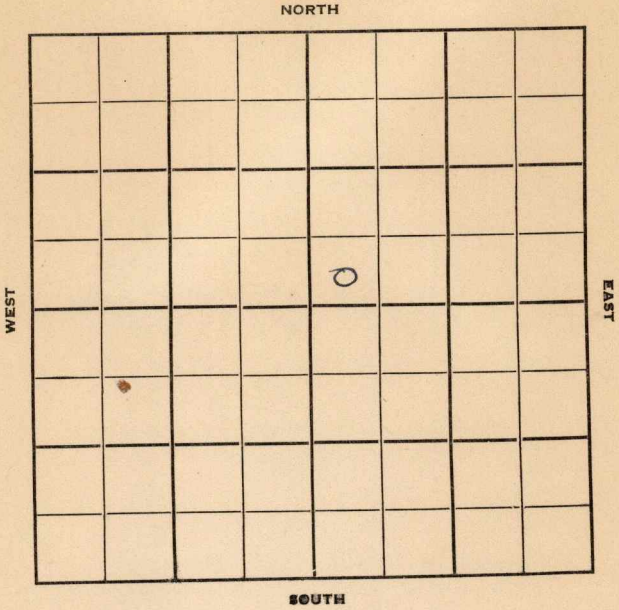

Russell

KANSAS

Sec. 26 Twp. 13 R. 14W

Well No. #1 Krug Farm

G. W. Davis et al Company

Barnett Drlg. Contractor
Russell Pool

Ft. from N. Line


330'

Ft. from S. Line

Ft. from E. Line

330'

Ft. from W. Line

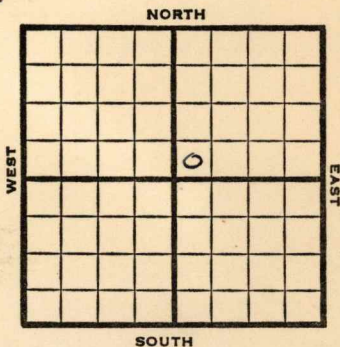

SW SW NE

1950 **Elev 1835**

REPORT

9/13 Location

10/4 Spud 9-15-50

8" @ 185

Anhy 859

Heeb 2932

Lans 2986

Arb 3290

TD 3300

D&A

ABANDONED

