


Section 26 Township 13 Range 14W

Well No. #3 Krug

Company Lewis Drlg.

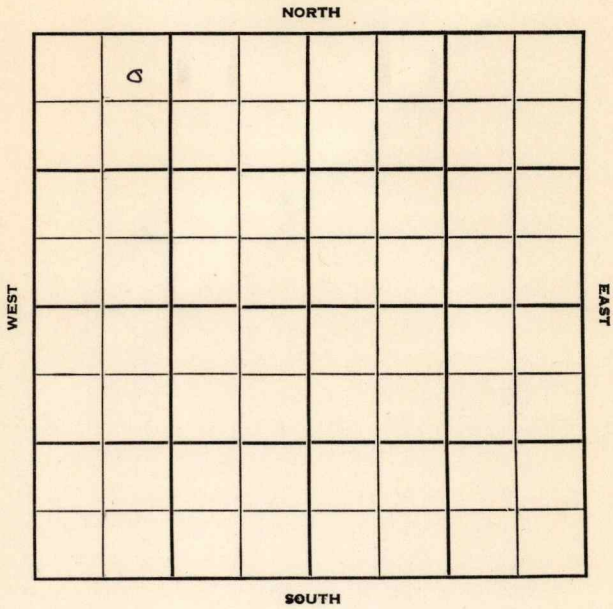

Russell

KANSAS

Sec. 26 Twp. 13 R. 14W

Well No. #3 Krug Farm

Lewis Drlg. Company

Lewis - Contr. Contractor

Russell


330' Ft. from N. Line

_____ Ft. from S. Line

_____ Ft. from E. Line

990' Ft. from W. Line

NE NW NW

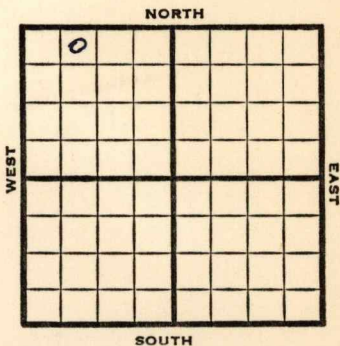

1952

Elev. 1840'

REPORT

2/6

Spud 1-30-52

8" @ 142

Anhy 885

Drlg. 2670

2/13

Arb. 3268 TD 3272 5" @ 3271

2/20

DD 3278' S/23 BO in 4 hrs 500 A
S/20 BOPH 1st hr. S/23 BO 2nd hr.
Shut in 8 hrs. fill up 2675' oil
POP

3/5

No report

3/12

"

3/19

Spud 1-30-52

Oil Well TD 3278 8" @ 142

Anhy 885

Heeb. 2930

Tor. 2950

Lans. 2988

DST 3082-89 open 1 hr. rec. 21' SGCM

Arb. 3268 TD 3272 5" @ 3271

DD 3278 S/ 23 bo 4 hr. 500 A

S/ 20 boph S/ 23 bo 2nd hr.

FU 2675' oil Comp. 50 bopd

COMPLETED

County Russell State KansasSec. 26 (Blk. Twp.) 13 (Sur. Rge.) 14W Map No.Operator Lewis Drlg.Well No. 3 Farm KrugElev. 1840 Location NE NW NW

0					

330 ft. From N Line NW990 ft. From W Line Quarter1st. Report FEB 6 1952

Completion _____

Remarks _____

Lewis - Contr.Spudding Date 1-30-52Drlg. Data Russell8" @ 142 Anhy 885 Drlg. 2670

J. G. McGEHEE

County Russell State Kansas
 Sec. 26 (Blk. 13) (Sur. 14W) Map No.
 Operator Lewis Drlg.
 Well No. 3 Farm Krug
 Elev. 1840 Location NE NW NW

o					

330 Ft. From N Line NW
990 Ft. From W Line Quarter

1st. Report

Completion MAR 19 1952

Remarks Russell Pool
Lewis Drlg. - Contr.

Spudding Date 1-30-52

Drlg. Data Oil well TD 3278

8" @ 142 Anhy 885 Heeb. 2930

Tor. 2950 Lans. 2988 DST 3082-89

open 1 hr. Rec. 21' sgcm Arb. 3268

TD 3272 5" @ 3271 DD 3278 S/ 23 bo

4 hr. 500 A S/ 20 boph S/ 23 bo 2nd

hr. FU 2675' oil Comp. 50 bopd

J. G. McGEHEE