


KANSAS

Section 26 Township 13 Range 14W

Well No. #1 City of Russell

Company Shields Oil
Stearns Drlg. Cont.

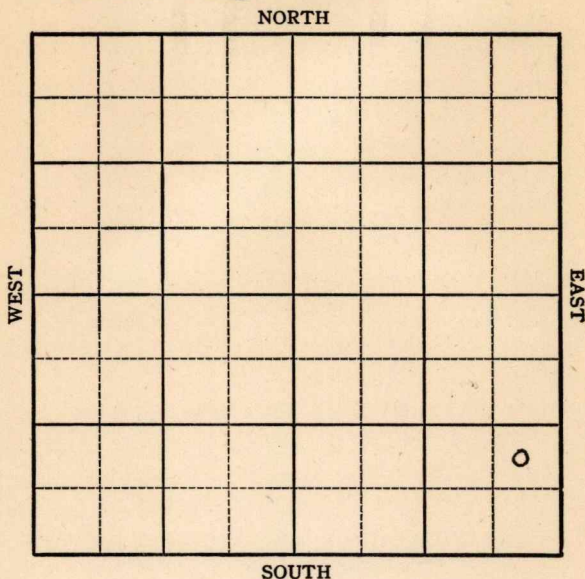

Russell KANSAS

Sec. 26 Twp. 13 R. 14W

Well No. #1 City of Russell Farm

Shields Oil

Russell Pool (Stearns Drlg., Cont.) Company


Ft. from N. Line

990' Ft. from S. Line

330' Ft. from E. Line

Ft. from W. Line

NE SE SE

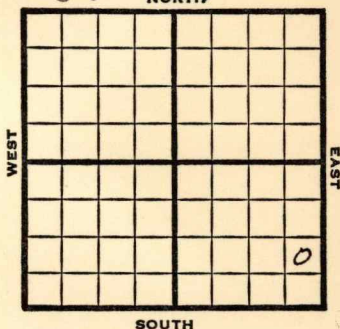

1949 Elev. 1830' REPORT

8/17 Location

8/24 "

8/31 "

9/7 Drlg. 455'

9/14 12"@ 475'

10"@ 835'

Drlg 1416'

9/21 Drlg. 2115'

9/28 8"@ 2438'

Drlg 2550'

10/5 Lansing 2994'

Drlg 3000'

10/12 Drlg 3230'

10/19 "

10/26 Arb 3275'

TD 3317'

ABANDONED

Map No. _____ Sec. 26 Twp. 13 R. 14W

Well No. 1 City of Russell

Shields Oil Company

Stearns Drlg. Contractor

NE SE SE

**FIRST REPORT
SECTION PLAT**

_____ Ft. from N. Line

990 Ft. from S. Line

330 Ft. from E. Line

_____ Ft. from W. Line

			o

Russell County

Location X

Rig up _____

Drilling and Remarks:

RECORD

Cased _____ in., _____ ft.

Sand _____

Gas _____

Oil _____

Total Depth _____

PRODUCTION

1st 24 hrs. Nat. _____

1st 24 hrs. after shot _____

Gas _____ Cu. Ft.

Dry Hole _____

Abandoned _____

Date

AUG 17 1949 19

S. J. LEWIS Scout

Kansas


Map No. _____ Sec. 26 Twp. 13 R. 14WWell No. 1 City of RussellShields Oil

Company

ABANDONED

Contractor

NE SE SE

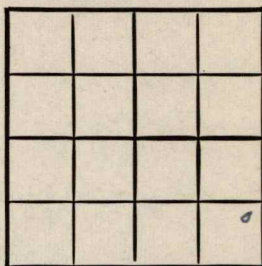E. 1880
SECTION PLAT

_____ Ft. from N. Line

990

_____ Ft. from S. Line

330

_____ Ft. from E. Line

_____ Ft. from W. Line

Russell County

Location _____

Rig up _____

Drilling and Remarks:

Pr & 9275

RECORD

Cased _____ in., _____ ft.

Sand _____

Gas _____

Oil _____

Total Depth 9212

PRODUCTION

1st 24 hrs. Nat. _____

1st 24 hrs. after shot _____

Gas _____ Cu. Ft.

Dry Hole _____

Abandoned _____

Date

OCT 26 1949 19S. J. LEWIS

Scout