


Section 24 Township 16 Range 12 W

Well No. #2 F. Hofmeister

Company Gulf

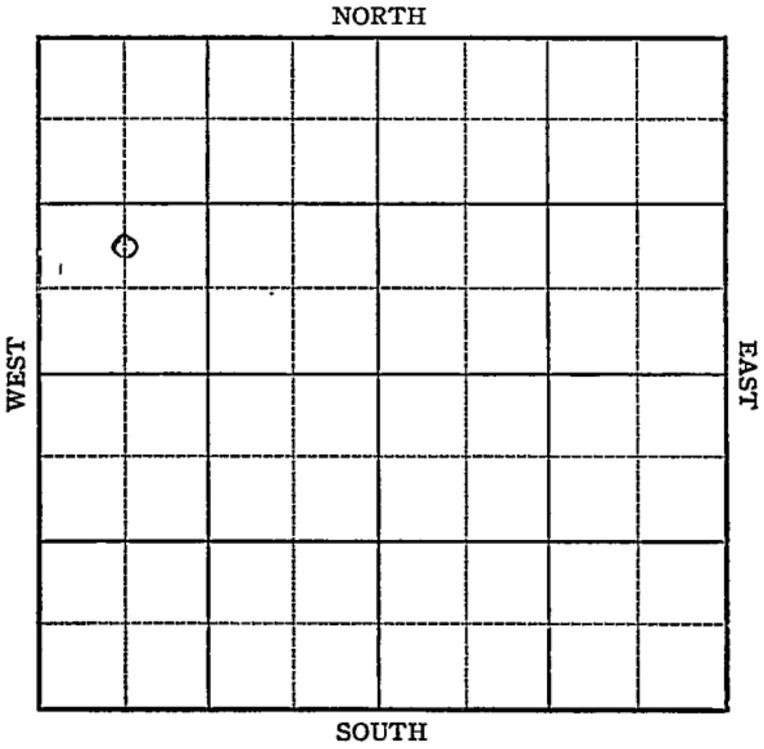

Sec. 24 Twp. 16 R. 12-W

Well No. #2 F. Hofmeister Farm

Gulf Company


_____ Ft. from N. Line

990 Ft. from S. Line

_____ Ft. from E. Line

660 Ft. from W. Line

Elev. 1910

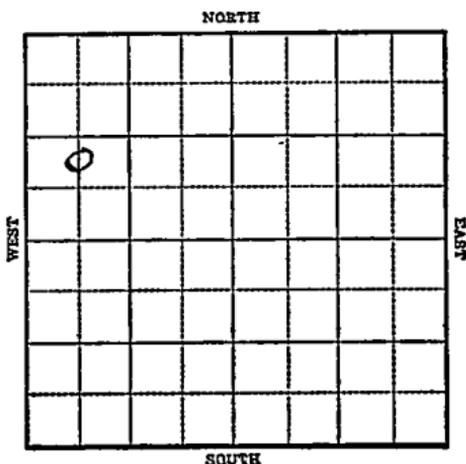

1943

R E P O R T

12/1 Location.
12/8 8" @ 420
WOC
12-15 Drilling 2750'

12/22 Lans 3069
No Arb
TD 3340
5" @ 3320
Rust

12/29 No shows SD
1944
1-5 " "
1-12 PB 3004
12 shots 3222-26
12 shots 3235-39

1/19 5" @ 3320
Lans 3069
Granite 3322
Perf. Lans
TD 3340
2000 acid
Pump 276 Pot.
Gravity 42

COMPLETED

Barton

KANSAS

Map No. 55 Sec. 24 Twp. 16 R. 12W

Well No. 2 P. Hofmeister

Gulf

Company

FIRST REPORT

Contractor

C N L SW NW

SECTION PLAT

o			

Ft. from N. Line

990 Ft. from S. Line

Ft. from E. Line

660 Ft. from W. Line

Beaver Pool

Location X

Rig up _____

Drilling and Remarks:

RECORD

Cased _____ in., _____ ft.

Sand _____

Gas _____

Oil _____

Total Depth _____

PRODUCTION

1st 24 hrs. Nat. _____

1st 24 hrs. after shot _____

Gas _____ Cu. Ft.

Dry Hole _____

Abandoned _____

Date

DEC 1 1943 19

S. J. LEWIS Scout

