


Section 26 Township 13 Range 14 W

Well No. # 1 Redeemer Luthern Church

Company Kim Oil

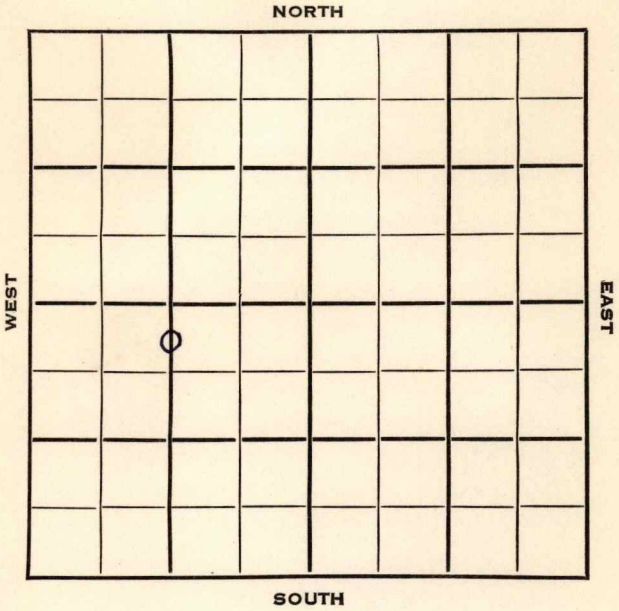

Russell KANSAS

SEC. 26 TWP. 13 R. 14W ✓


WELL NO. 1 Redeemer Lutheran Church FARM

COMPANY Kim Oil

CONTRACTOR Mast Drlg.

Russell Townsite Pool

330 Ft. from N. Line
 _____ Ft. from S. Line
 _____ Ft. from E. Line
 1320 Ft. from W. Line

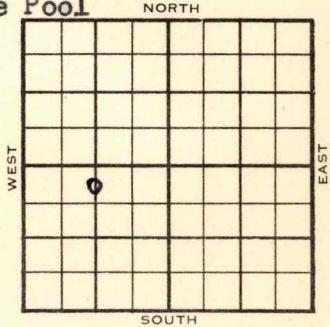

C N2/ N/2 SW

1954 ELEVATION 1828' REPORT

5/12 Spud 5-7-54
 8" @ 213'
 Drlg. 1450'

5/19 Drlg. 3055'

6/2 Spud 5-7-54
 8" @ 213'
 Lans 2987', Arb. 3296'
 TD 3310'
 D&A

ABANDONED

County Russell State Kansas

Sec. 26 (Blk. Twp.) 13 (Sur. Rge.) 14W Map No.

Operator Kim Oil

Well No. 1 Farm Redeemer Lutheran Church

Elev. 1828 Location C N $\frac{1}{2}$ N $\frac{1}{2}$ SW

ABANDONED

330 Ft. From N Line SW

1320 Ft. From W Line Quarter

1st. Report

Completion JUN 2 1954

Remarks Russell Townsite Pool

Mast Drlg. - Contr.

Spudding Date 5-7-54

Drlg. Data
8" @ 213 Lans. 2987 Arb. 3296 TD 3310

D & A