


Section 26 Township 13 Range 14 W

Well No. # 2 Russell School

Company Trans-Era

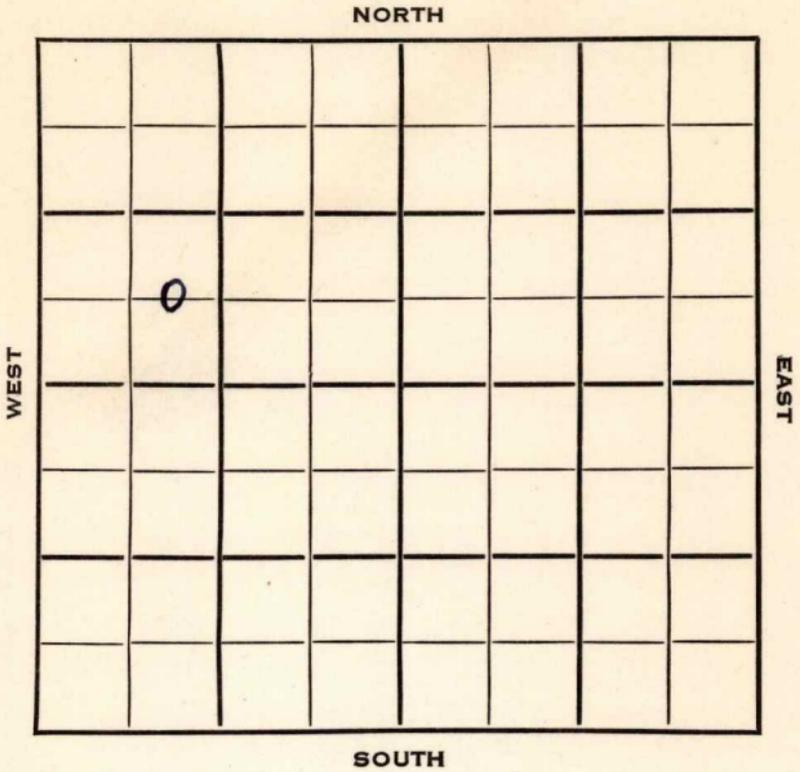

Sec. 26 Twp. 13 R. 14W

Well No. #2 Russell School Farm

Trans-Era Company

Trans-Era Contractor

NE Russell Pool


Ft. from N. Line

660 Ft. from S. Line

Ft. from E. Line

990 Ft. from W. Line

C E L SW NW

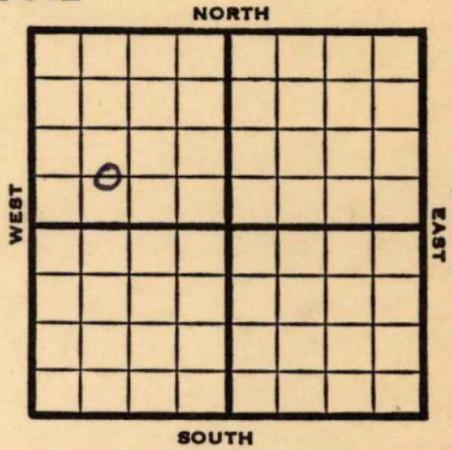

1953 Elev. 1836' REPORT

5/27 Spud 5-20-53
 8" @ 257'
 Anhy 852'
 Top. 2700'
 Drlg 2752'

6/3 Heeb 3929, Lans 2987, B. KC 3248, Arb 3274
 TD 3276'
 5" @ 3275'

6/10 Spud 5-20-53
 Oil Well
 TD 3276'
 8" @ 257'
 Anhy 852, Top 2700, Heeb 2929, Lans 2987, B KC 3248, Arb 3274,
 TD 3276
 5" @ 3275'
 CO to 3276 B/ 1/2 boph 500 A
 1500 A S/ 30 boph
 Comp. 50 bopd.

COMPLETED

County Russell State Kansas

Sec. 26 (Blk. 13) (Sur. 14W) (Rge.) Map No.

Operator Trans-Era

Well No. 2 Farm Russell School

Elev. 1836 Location C E L SW NW



660 Ft. From S Line NW

990 Ft. From W Line Quarter

1st. Report

Completion JUN 10 1953

Remarks NERussell Pool

Trans-Era - Contr.

Spudding Date 5-20-53

Drilg. Data Oil well TD 3276

8" @ 257 Anhy 852 Top. 2700

Heeb. 2929 Lans. 2987 B KC 3248

Arb. 3274 TD 3276 5" @ 3275

CO to 3276 B/ 1/2 boph 500 A

1500 A S/ 30 boph Comp. 50 bopd