


Section 26 Township 13 Range 14 W

Well No. # 3 Russell School

Company Trans-Era

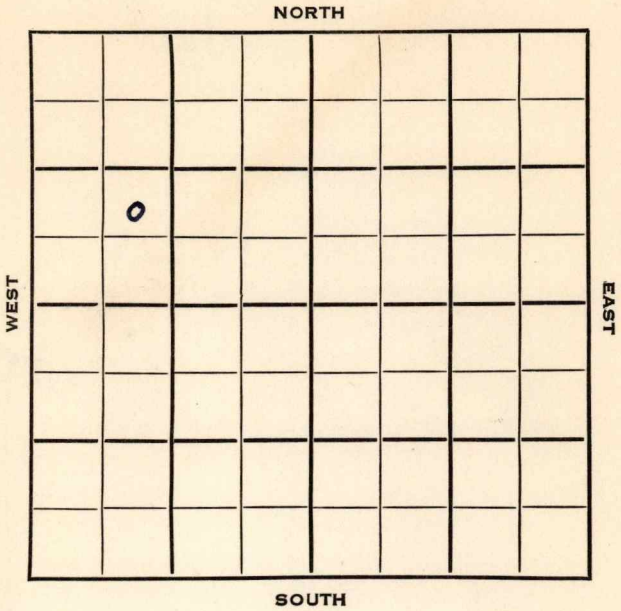

Sec. 26 Twp. 13 R. 11W

Well No. #3 Russell School Farm

Trans-Era Company

Trans-Era Contractor

Russell Pool


Ft. from N. Line

850 Ft. from S. Line

Ft. from E. Line

900 Ft. from W. Line

NE SW NW

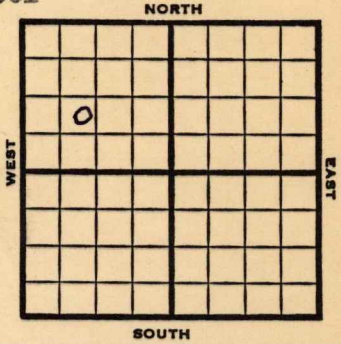

1953 Elev. 1837' REPORT

6/10 Spud 6-5-53
8" @ 287'
Drlg 1475'

6/24 Top 2706 KC 2997 Cong 3278
Arb. 3290 TD 3293 5" @ 3251
CO 3293 250 A 500 A 13 GOPH
1000 A No help 1500 A

7/1 Spud 6-5-53 Oil well TD 3293
8" @ 287 Top 2706 KC 2997
Cong. 3278 Arb. 3290
TD 3293 5" @ 3251 CO to 3293
DD 3295 250 A 5 GOPH 500 A
13 GOPH 1000 A 1500 A
Comp. 50 BOPD 75 BW

COMPLETED

County Russell State Kansas

Sec. 26 (Blk.) 13 (Sur.) 14W Map No.

Operator Trans-Era

Well No. 3 Farm Russell School

Elev. 1837 Location NE SW NW

0					
FIRST REPORT					

850 Ft. From S Line NW

900 Ft. From W Line Quarter

1st. Report JUN 10 1953

Completion _____

Remarks _____

Trans-Era - Contr.

Spudding Date 6-5-53

Drlg. Data Russell Pool

8" @ 287 drlg. 1475

J. G. MCGEHEE
MCGEHEE

