

KANSAS


Barton

FORM 51 5M PETROL

Section 25 Township 16 Range 12W

Well No. 4 Case

Company Gulf

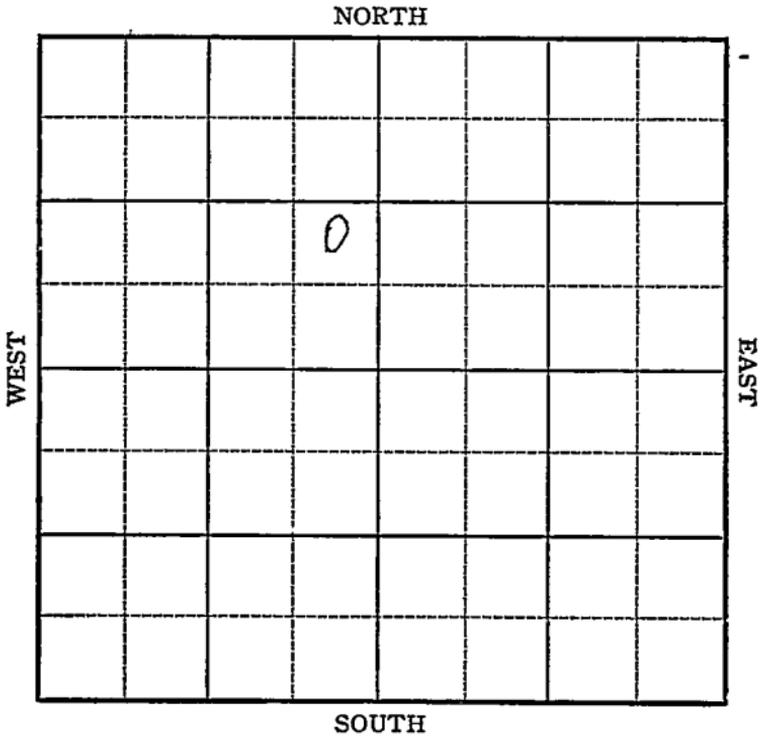

KANSAS

Sec. 25 Twp. 16 S R. 12 W

Well No. #4 Case Farm

GULF Company

Kraft-Prusa


Ft. from N. Line

990' Ft. from S. Line

330' Ft. from E. Line

Ft. from W. Line

NE SE NW

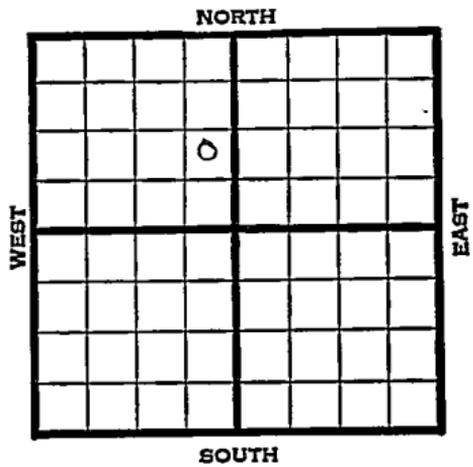

1945

REPORT

Elev. 1926

4-18

Location

4/27

8" @ 585' WOC

5/3

Drlg. 2665

5/10

Lans 3070
Pre Camb. 3316-3337

TD 3337

5" @ 3283' RUST

5/17

PB 3262
26 shots 3248-3253
15 shots 3222-3225
30 shots 3104-3108
20 shots 3074-3078 3000 acid.
Pump 88 oil in 6 hrs.

5/24

" " " " " " "

5/29

Lans 3070
Pre Camb 3316
5" @ 3283
Perf. Lans. 3000 acid.
TD 3337
Pump 321 Pot.
Grav. 42.3

COMPLETED

Kansas Pool Name Kraft-Prusa

Map No. 55 Sec. 25 Twp. 16 R. 12 W

Well No. 4 Case

Gulf Company

FIRSI REPORT Contractor

NE SE NW

SECTION PLAT

_____ Ft. from N. Line
990 Ft. from S. Line
330 Ft. from E. Line
 _____ Ft. from W. Line

	o		

Barton

Location X

Rig up _____

Drilling and Remarks:

RECORD

Cased _____ in., _____ ft.
 Sand _____
 Gas _____
 Oil _____
 Total Depth _____

PRODUCTION

1st 24 hrs. Nat. _____
 1st 24 hrs. after shot _____
 Gas _____ Cu. Ft.
 Dry Hole _____
 Abandoned _____

Date

APR 18 1945 19 _____ S. J. LEWIS Scout

Kansas Pool Name Kraft-Prusa

Map No. 55 Sec. 25 Twp. 16 R. 12W

Well No. 4 Case

Gulf Company

COMPLETED Contractor

NE SE NW

E 1/1926
SECTION PLAT

	0		

_____ Ft. from N. Line

990 Ft. from S. Line

330 Ft. from E. Line

_____ Ft. from W. Line

Barton County

Location _____

Rig up _____

Drilling and Remarks:

Lease 3070
Pre Case 43216
5" 3283
Prof Lease
3000 acid
Pump 32128

RECORD

Cased _____ in., _____ ft.

Sand _____

Gas _____

Oil _____

Total Depth 2227

PRODUCTION

1st 24 hrs. Nat. _____

1st 24 hrs. after shot _____

Gas _____ Cu. Ft.

Dry Hole _____

Abandoned _____

Date

42³ 52

MAY 29 1945 19

S. J. LEWIS

Scout