


Russell

KANSAS

Section 26 Township 13 Range 14W

Well No. #1 Lamer-Krug

Company Lewis Drlg.

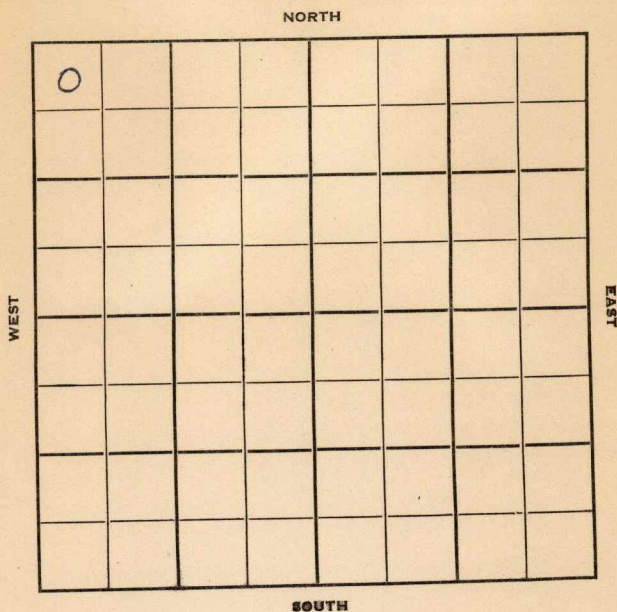

Russell

KANSAS

Sec. 26 Twp. 13 R. 14W

Well No. #1 Lamer-Krug Farm

Lewis Drlg.

Company

Lewis

Contractor

Russell Pool


330' Ft. from N. Line

Ft. from S. Line

Ft. from E. Line

330' Ft. from W. Line

NW NW NW

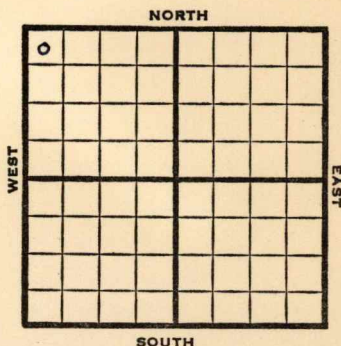

1950

REPORT

Elev 1840

9/13 RUR

10/25 Spud 9-9-50

8" @ 141

Anhy 815

Heeb 2916

Douglas 2935

Lans 3980

SO 2987-91

2995-99 3003-07

DST 2985-3015 opn 1 hr rev 69' ocm

240' mud cut water

SO 3021-25

DST 3015-30 opn 1 hr rec 60' hocm

270' oil SO 3066-72

3076-83

DST 3061-81 opn 1hr rec 30' ocm

90' mud & water

Arb 3258

5" @ 3259

TD 3265

500 A

8 boph

DD 3278 S/20 boph for 12 hr

Comp 100 bopd

Completed TD 3278

COMPLETED

County Russell State KansasSec. 26 (Blk. 13 (Sur. 14W (Twp. Rge.) Map No.Operator Lewis Drlg.Well No. 1 Farm Lamer - KrugElev. 1840 Location NW NW NW

0					

330 Ft. From N Line NW330 Ft. From W Line Quarter1st. Report SEP 13 1950

Completion _____

Remarks _____

Spudding Date _____

Drlg. Data Russell PoolRUR

J. E. TYRA

County Russell State KansasSec. 26 (Blk.) 13 (Sur.) 14W Map No.Operator Lewis Drlg.Well No. 1 Farm Lamer - KrugElev. 1840 Location NW NW NW

0				

330 Ft. From N Line NW330 Ft. From W Line Quarter

1st. Report

Completion OCT 25 1950Remarks NE Russell PoolLewis Drlg. - Contr.Spudding Date 9-9-50Drlg. Data Oil well TD 32788" @ 141 Anhy 815 Heeb. 2916Douglas 2935 Lans. 2980 SO 2987-912995-99 3003-07 DST 2985-3015 open 1 hrRec. 69' ocm 240' mud cut waterSO 3021-25 DST 3015-30 open 1 hr.Rec. 60' hocm 270' oil SO 3066-723076-83 DST 3061-81 open 1 hr.Rec. 30' ocm 90' mud & water Arb. 32585" @ 3259 TD 3265 500 A 8 bophDD 3278 S/ 20 boph for 12 hr.Comp. 100 bopd

J. E. TYRA