


Section 25 Township 16 Range 12-W

Well No. #3 Martha Case

Company Gulf

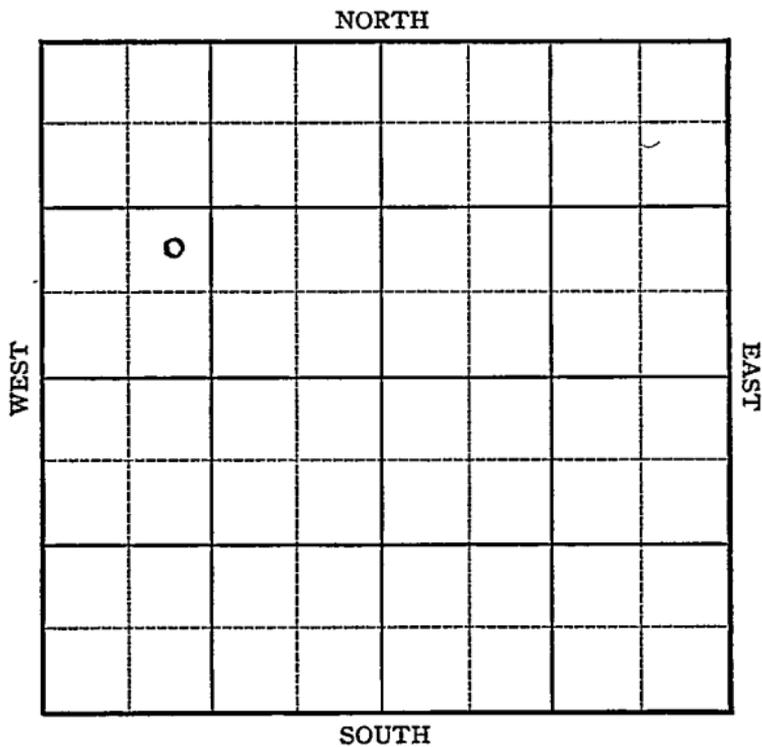


Barton

Sec. 25 Twp. 16 R. 12-W

Well No. #3 Martha Case Farm
Gulf Company

NORTH

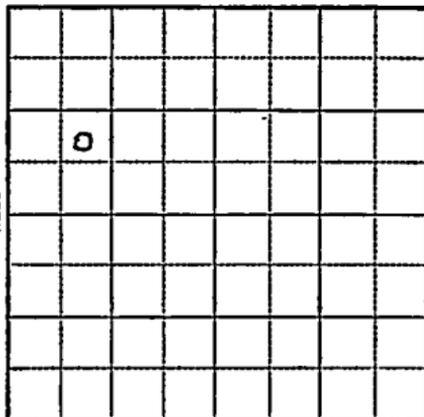

_____ Ft. from N. Line

990 Ft. from S. Line

_____ Ft. from E. Line

990 Ft. from W. Line

Elev. 1925

1948

R E P O R T

- 1/5 Rotary
- 1-12 10" @ 414
Drlg 915'
- 1/19 Drlg. 2520'
- 1/26 Lans 3075
SO 3079-81, 3245-48
No Arb
Granite 3707-11 TD
6" @ 3308
Rust
- 2/2 23 shots 3324-49 ;
200 acid PB
- 2/8 PB 3207-23 shots 2910-15,
2000 acid
Pump; 6 oil & 9 water in 24 hrs.
- 2/16 6" @ 3308
Lans 3075
No Arb
Granite 3707
TD 3311
Water

ABANDONED

Barton

KANSAS

Map No. 25 Sec. 25 Twp. 16 R. 12W

Well No. 3 Martha Case

Gulf Company

FIRST REPORT Contractor

NE SW NW

_____ Ft. from N. Line

990 Ft. from S. Line

_____ Ft. from E. Line

990 Ft. from W. Line

SECTION PLAT

o			

BEAVER POOL

Location _____

Rig up _____

Drilling and Remarks:

Rotary

RECORD

Cased _____ in., _____ ft.

Sand _____

Gas _____

Oil _____

Total Depth _____

PRODUCTION

1st 24 hrs. Nat. _____

1st 24 hrs. after shot _____

Gas _____ Cu. Ft.

Dry Hole _____

Abandoned _____

Date

JAN 5 1944 19

S. J. LEWIS Scout

KANE

Map No. Sec. **25** Twp. **16** R. **12W**

Well No. **3 Martha Case**

Gulf Company

ABANDONED Contractor

NE SW NW

SECTION PLAT

o			

_____ Ft. from N. Line

990 Ft. from S. Line

_____ Ft. from E. Line

990 Ft. from W. Line

Beaver Pool

Location _____

Rig up _____

Drilling and Remarks:

*Lean 3075
No oil
Granite 3707
6" @ 3908
Water*

RECORD

Cased _____ in., _____ ft.

Sand _____

Gas _____

Oil _____

Total Depth 3811

PRODUCTION

1st 24 hrs. Nat. _____

1st 24 hrs. after shot _____

Gas _____ Cu. Ft.

Dry Hole _____

Abandoned _____

Date

FEB 16 1944 19

S. J. LEWIS Scout