

KANSAS


FORM 51 5M 10-41 PETROL

Barton

Section 25 Township 16 Range 12-W

Well No. #2 Oeser

Company Lauch & Moncrief

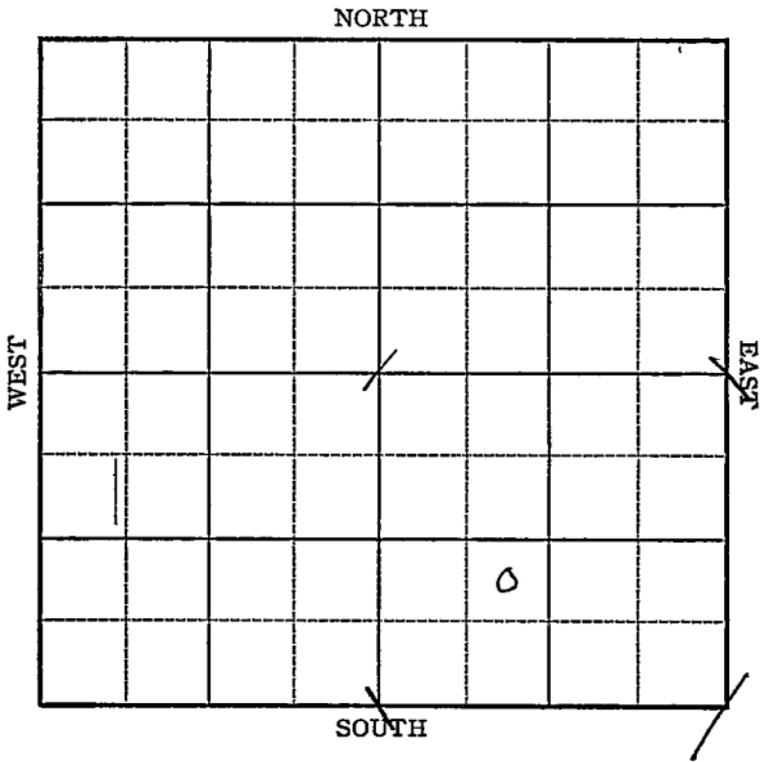

Sec. 25 Twp. 16 R. 12-W

Well No. #2 Oeser Farm

Lauch & Moncrief Company


Beaver

_____ Ft. from N. Line

990 Ft. from S. Line

_____ Ft. from E. Line

990 Ft. from W. Line

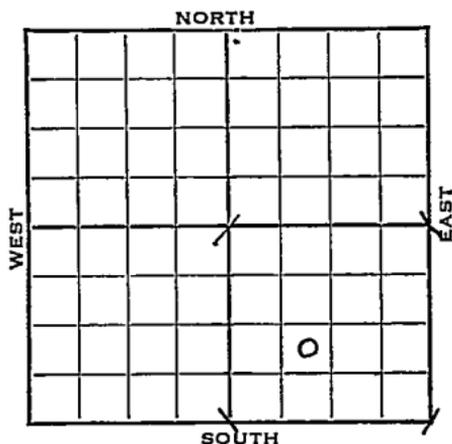

NE SW SE Elev. 1916

1943

REPORT

1/13

Rotary

1/20

8" Casing set 152'
TD 1802' SD.

1/27

Drlg. 2612'

2/3

Basal sd 3292
T.D. 3296'
5" @ 3292' RUST

2/10

Quartzite 3373
5" @ 3300'
T.D. 3393'
6 gals oil per hr.

2/17

Quartzite 3373
5" @ 3300'
T.D. 3393'
P.B. 2932'
63 shots 2895-2907 in Topeka
3000 gal acid
Pump 160 Pot.
Gravity 36.8

COMPLETED

KANSAS 55 Map No. 55 Sec. 25 Twp. 16 R. 12W

Well No. 2 Oeser

Lauch & Moncrief Company

COMPLETED Contractor

NE SW SE

SECTION PLAT

		.	
		e	

_____ Ft. from N. Line

990 Ft. from S. Line

_____ Ft. from E. Line

990 Ft. from W. Line

BEAVER POOL

Location _____

Rig up _____

Drilling and Remarks:

I was to be 3373

5" @ 3306

Plug 2932

68 shots 2895-2907

in Topok

3000 acid

Pump 16 D Prod.

Date

3/6/32

RECORD

Cased _____ in., _____ ft.

Sand _____

Gas _____

Oil _____

Total Depth 3273

PRODUCTION

1st 24 hrs. Nat. _____

1st 24 hrs. after shot _____

Gas _____ Cu. Ft.

Dry Hole _____

Abandoned _____

FEB 17 1943

19

S. J. LEWIS

Scout