


Section 26 Township 13 Range 14-W

Well No. #1 School Land

Company Lewis Drlg.

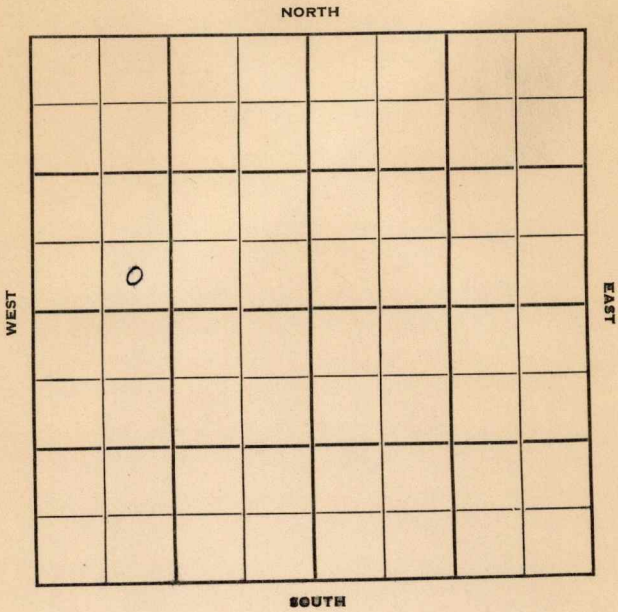

Sec. 26 Twp. 13 R. 14-W

Well No. #1 School Land Farm

Lewis Drlg. Company

Lewis Drlg. Contractor

Sellens


\_\_\_\_\_ Ft. from N. Line

330 Ft. from S. Line

\_\_\_\_\_ Ft. from E. Line

990 Ft. from W. Line

SE SW NW

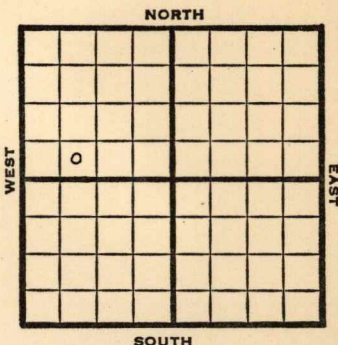

1950

**Elev 1838**

REPORT

9/20

Location

10/4

Spud 9-19-50

8 5/8" @ 141

**Anhy 858**

**Heeb 2928**

**Lans 2993**

DST 2996-3043 opn 1/2 hr rec 10' ocm

30' mud 50' sw

SO 3171-73 3178-81

**Cong 3266**

**Arb 3284**

TD 3295

B&A

**ABANDONED**



