

KANSAS


Barton County

FORM 51 5M PETROL

Section 25 Township 16 Range 12W

Well No. 4 Oeser (B) - KGF DAL

Company D. J. Marshall

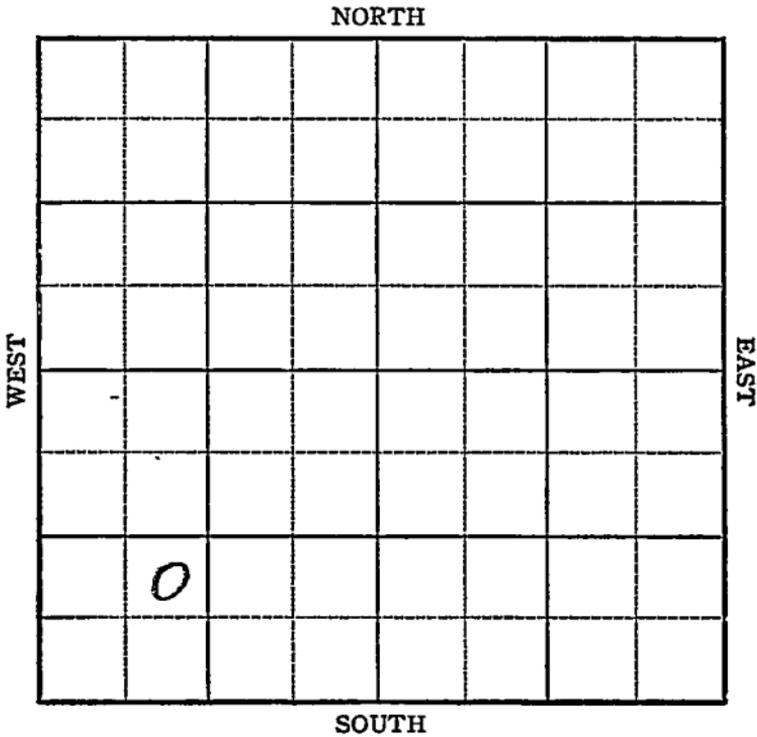

Sec. 25 Twp. 16 R. 12W

Well No. 4 Oeser "B" Farm _____

D. J. Marshall Company _____

Kraft-Prusa

_____ Ft. from N. Line


990

_____ Ft. from S. Line

_____ Ft. from E. Line

990

_____ Ft. from W. Line

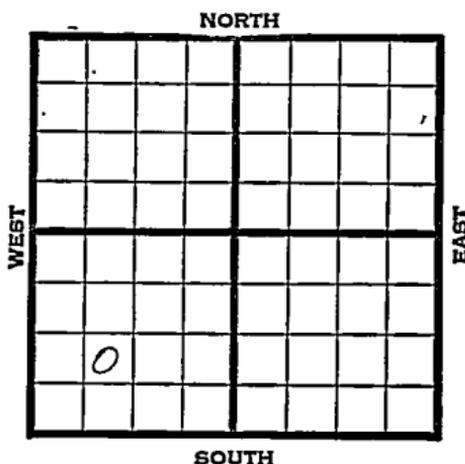

NE SW SW

Elev. 1936

1945

REPORT

6/5

8" -532
Anhy 760
1600

6/14

Drlg. 2972'

6/21

Lams 3095
Quartzite 3339
Run csg

6/28

5" @ 3335 RUST

7/3

" " "

7/11

" " "

7/19

" " "

7/26

Cong. 3337
Drlg. 3375'

8/1

Perf. 3372
Basal 3376
Drlg. 3393

8/8

" "

8/15

Granite 3394
TD 3394
Plug 3127
23 shots 3109-3117 3000 acid
No help, sque. Perf.

8/22

" " " " "

8/29

" " " " "

9/5

Granite 3394
TD 3394'

ABANDONED

