


Section 26 Township 13 Range 14W

Well No. #1 Somer

Company Stearns Petr.

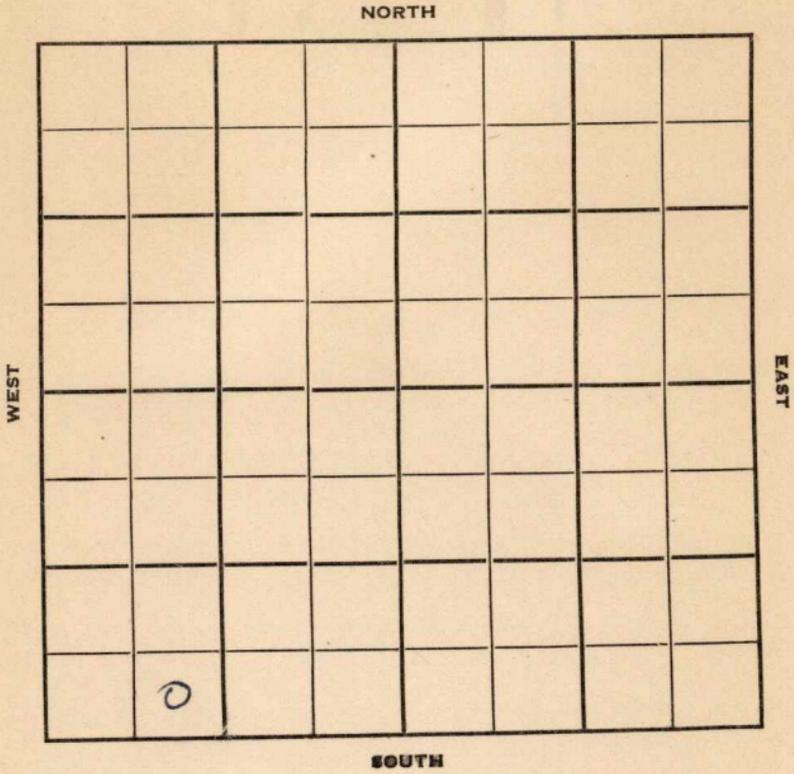

Russell

KANSAS

Sec. 26 Twp. 13 R. 14W

Well No. #1 Somer Farm

Stearns Petroluem Company

Stearns Drlg. - Contr. Contractor

Russell Pool


Ft. from N. Line

255' Ft. from S. Line

Ft. from E. Line

810' Ft. from W. Line

SE SW SW

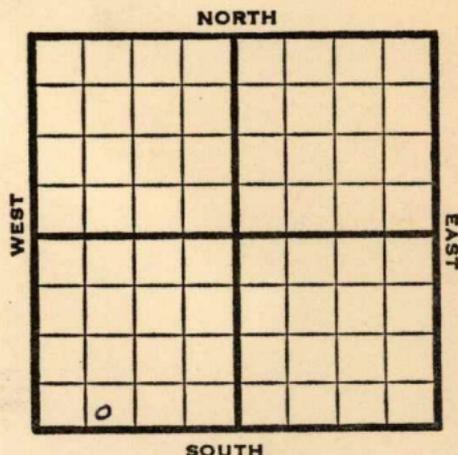

1950

Elev. 1827' REPORT

9/13

RUR

9/27

Spud 9-12-50

D&A TD 3328'

8" @ 199'

Anhy 850'

Lans. 2985'

DST 2985-3004 opn $\frac{1}{2}$ hr Rec. 10' mud

Arb. 3276'

DST 3276-3301 opn $\frac{1}{2}$ hr

Rec. 40' mud wtr TD 3328'

D&A

ABANDONED


County Russell State Kansas

Sec. 26 (Blk. 13) (Sur. 14W) (Twp. 13) Map No.

Operator Stearns Petroleum

Well No. 1 Farm Somer

Elev. 1827 Location SE SW SW

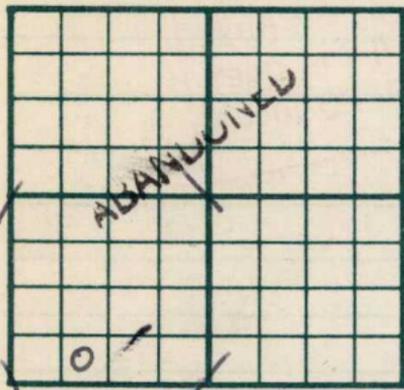

255 Ft. From S Line SW

810 Ft. From W Line Quarter

Ist. Report

SEP 27 1950

Completion

Remarks Russell Pool

Stearns Drlg. - Contr.

Spudding Date 9-12-50

Drlg. Data D & A TD 3328

8" @ 199 Anhy 850 Lans. 2985

DST 2985-3004 open $\frac{1}{2}$ hr. Rec. 10' mud

Arb. 3276 DST 3276-3301 open $\frac{1}{2}$ hr.

Rec. 40' mud ' water TD 3328

D & A