


Section 26 Township 13 Range 14 W

Well No. # 2 Streck

Company Lewis Drlg.

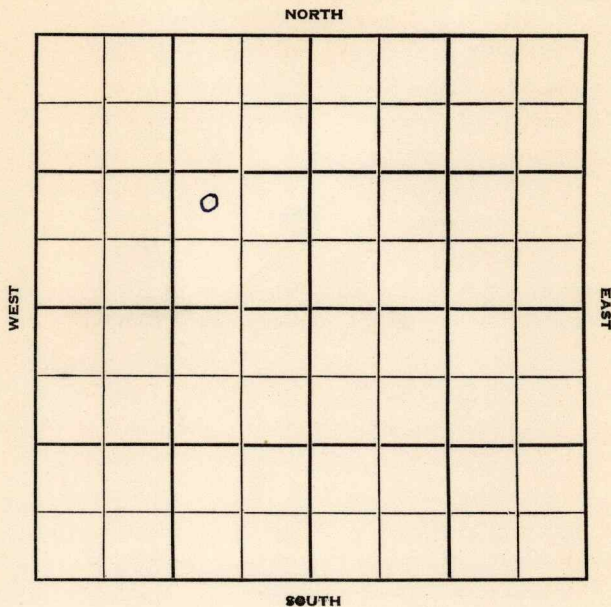

KANSAS

Russell

Sec. 26 Twp. 13 R. 14W ✓

Well No. #2 Streck Farm

Lewis Drlg. Company

Contractor

Russell Pool


 Ft. from N. Line

990' Ft. from S. Line

990' Ft. from E. Line

 Ft. from W. Line

NW SE NW

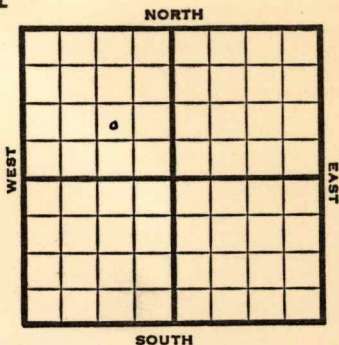

1951

Elev. 1838'

REPORT

3/28

Spud 3-24-51

8" @ 167

Anhy 870

Drlg. 895'

5/23

Spud 3-24-51 Oil well TD 3292'

8" @ 167 **Anhy 870'** **Heeb 2940'**

KC 2994'

DST 3069-92 open 20 min. rec 6' mud

Arb. 3277-92'

DST 3277-92 open 1 hr. rec 390' GCO

5" @ 3281 TD 3292' S/7 BOPH

Comp. 356 BOPD

COMPLETED

County Russell State KansasSec. 26 (Blk.) 13 (Sur.) 14W Map No.Operator Lewis Drlg.Well No. 2 Farm StreckElev. Location NW SE NW990 Ft. From S Line NW990 Ft. From E Line Quarter1st. Report MAR 28 1951

Completion

Remarks

Spudding Date 3-24-51Drlg. Data Russell Pool8" @ 167 Anhy 870 drlg. 895

