


Section 25 Township 16 Range 12W

Well No. 5 Oser


Company Locke & Moncrief

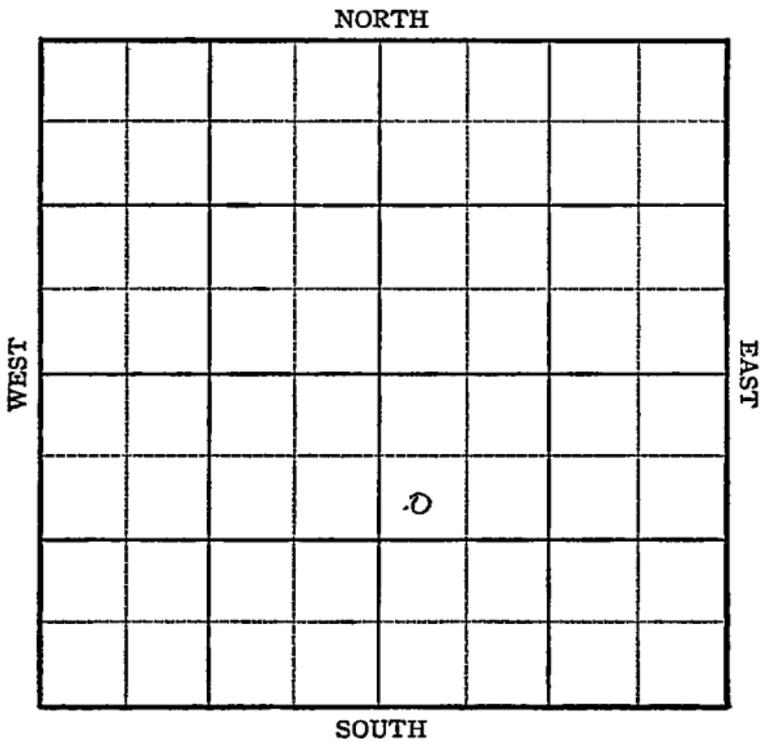

Sec. 25 Twp. 16 R. 12-W

Well No. #5 Oser Farm _____
Locke & Moncrief Company _____

990 Ft. from N. Line
 _____ Ft. from S. Line
 _____ Ft. from E. Line
330 Ft. from W. Line

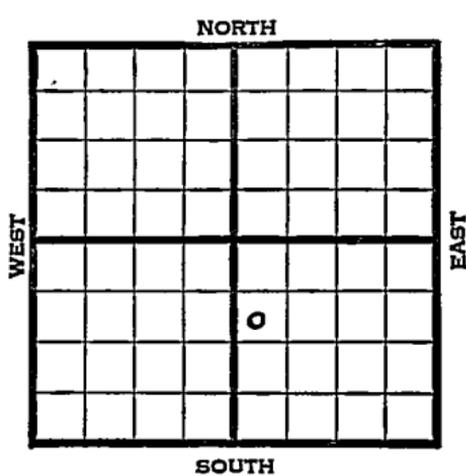

SW NW SE Elev. 1923

1945

REPORT

- 8/8 Location
- 8/15 Rig
- 8/22 Drlg. 160
- 8/29 15" @ 447
Drlg. 610'
- 9/5 Anhy 764
12" @ 765
Drlg. 1310
- 9/112 10" @ 2060
Drlg. 2080
- 9/19 8" @ 2500
Drlg. 2715'
- 9/26 Lans 3066
7" @ 3063
TD 3073'
- 10/3 TD 3195' SO
- 10/10 " " "
- 10/17 Quartzite 3287
5" @ 3300
TD 3300 RUST
- 10/24 PB 3266
55-shots 3065-3080 1000 acid.
Swb. 7 oil per hr.
- 10/31 " " " " " "
- 11/7 " " " " " "
- 11/14 " " " " " "
- 11/21 " " " " " "
- 11/28 TD 3300'
- 12/5 5" @ 3300 TD

OVER

1945

12/12 Låns 3086
Quartzite 3287
5" @ 3300
Perf. Låns 1110 acid.
TD 3300'
Pump 97 Pot.
Grav. 42.0

COMPLETED

Map No. _____ Sec. 25 Twp. 16 R. 12W

Well No. 6 Oeser

D. R. Lauck _____ Company

FIRST REPORT _____ Contractor

NW SE

SECTION PLAT

330 Ft. from N. Line

_____ Ft. from S. Line

_____ Ft. from E. Line

330 Ft. from W. Line

		o	

Barton County

Location _____

Rig up _____

Drilling and Remarks:

10" @ 251
anhy 765
drlg. 1950

RECORD

Cased _____ in., _____ ft.

Sand _____

Gas _____

Oil _____

Total Depth _____

PRODUCTION

1st 24 hrs. Nat. _____

1st 24 hrs. after shot. _____

Gas _____ Cu. Ft.

Dry Hole _____

Abandoned _____

Date

FEB 25 1948 19 _____ S. J. LEWIS Scout

Map No. 55 Sec. 25 Twp. 16 R. 12W

Well No. 6 Oeser

D. R. Lauck Company

COMPLETE

Contractor

NW SE

E 11927
SECTION PLAT

330 Ft. from N. Line

 Ft. from S. Line

 Ft. from E. Line

330 Ft. from W. Line

		0	

Barton County

Location

Rig up

Drilling and Remarks:

Wane 3056
Quartzite 3278
5' @ 279
Perf Wane
1000 acid
Flow 75 oil Prod
42° SW

RECORD

Cased in., ft.

Sand

Gas

Oil ✓

Total Depth 3279

PRODUCTION

1st 24 hrs. Nat.

1st 24 hrs. after shot

Gas Cu. Ft.

Dry Hole

Abandoned

Date

MAY 5 1948 19 S. I. LEWIS Scout