

Section 26 Township 12 Range 16 W

Well No. # 2 Furth

Company Kewanee Oil

NORTH

		0					

WEST

EAST

SOUTH

Sec. 26 Twp. 12 R. 16W

Well No. #2 Furth Farm _____
Kewanee Oil Company _____
Gross Drlg. Contractor _____


936 Ft. from N. Line

_____ Ft. from S. Line

936 Ft. from E. Line

_____ Ft. from W. Line

SW NE NW

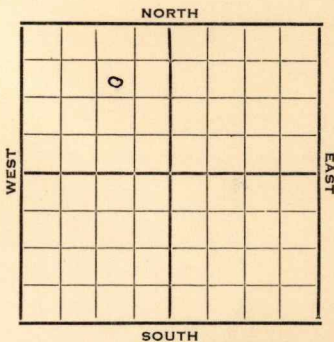

1952

Elv. 1922

REPORT

7/30 Spud 7-29-52
 8/6 Anhy 1067
 Drlg. 2399'
 8/13 Arb. 3401 RTD 3404
 7" @ 3402'
 8/20 Heeb 3081' Dodge 3101' Lans. 3130'
 Arb. 3401' DD 3408' P/3 BOPH
 8/27 N.R.
 9/3 "
 9/10 Spud 7-29-52
 Oil Well TD 3408
 8" @ 208
 Anhy 1067 Heeb. 3081
 Dodge 3101 Lans. 3130
 Arb. 3401 TD 3404
 7" @ 3402 DD 3408
 P/3 boph 3500 A P/83 bf 3% wtr.
 Comp. 80 bopd 3bw

COMPLETED

County Ellis State Kansas

Sec. 26 (Blk. 12 (Sur. 16W (Twp.) (Rge.) Map No.

Operator Kewanee Oil

Well No. 2 Farm Furth

Elev. 1922 Location SW NE NW

936 Ft. From N Line NW

936 Ft. From E Line Quarter

1st. Report

Completion SEP 10 1952

Remarks

Gross Drlg. - Contr.

Spudding Date 7-29-52

COMPLETE

Drlg. Data Oil well TD 3408

8" @ 208 Anhy 1067 Heeb. 3081

Dodge 3101 Lans. 3130 Arb. 3401

TD 3404 7" @ 3402 DD 3408 P/ 3 boph

3500 A P/ 83 bf 3% water

Comp. 80 bopd 3 bw