


Section 26 Township 12 Range 16W

Well No. #1 Furthmeyer

Company Leo Wentworth Drlg.

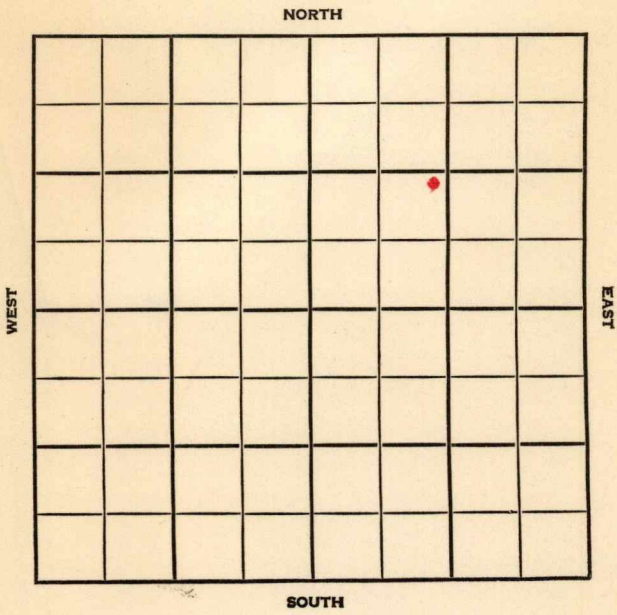

KANSAS

WELL NO. _____

1 Furthmeyer

FARM

COMPANY

^Y
Claude
- Leo Wentworth Drlg.

CONTRACTOR

Co. tools


Emmran

Ft. from N. Line

Ft. from S. Line

Ft. from E. Line

Ft. from W. Line

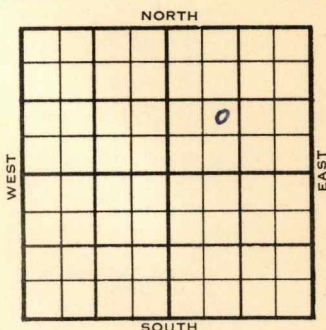

NE SW NE

Kewanee FO

ELEVATION

REPORT

1955

6/8

Comm. 6-6-55

66/29

8 5/8" @ 132/75, DST 2887-2902 op 1hr.
Rec. 5' socm 0/20", DST 3158-3208 op.
1 hr. Rec. 135' gas 15' socm 30' oil
spotted mw 120' wtr. 940/20" DST
3225-55 open 1 hr. Rec. 15' gas 15'
vsocm 100/20" DST 3400-30 open 1 hr.
Rec. 12' mud 100#, D&A.

Tops:	Depth	Log	Datum
Ann	844		
TP.	2834	2836	898
H.	3107	3106	1168
Tr.		3126	1188
KC.	3158	3157	1219
A.	3422	3422	1484
TD.	3461		

ABANDONED

County Ellis Elev. _____
 Sec. 26 Twp. 12 Rge. 16W
 Company Leo Wentworth Drlg.
 Farm Name Furthmeyer No. 1

TOPS	DEPTH	LOG	DATUM	Loc. in Sec.
Anh.				NE SW NE
Tp.				
H.				
Tr.				
Dg.				
RI.				
L.				Geol.
K.C.				Contr.
B.K.C.				Co. tools
Ce.				Pool
C.				Embran
M.				
M.				
K.				
Mz.				
Mq.				
V.				
S.				
S.				
A.				
R.				
PE.				
G.				
T.D.				

Date Comm. 6-6-55 Kewanee farmout

JUN 8 1955
 FIRST REPORT

County Ellis Elev. 1938 KB
 Sec. 26 Twp. 12 Rge. 16W
 Company Claude Wentworth Drlg.
 FarmName Furthmeyer No. 1

TOPS	DEPTH	LOG	DATUM	Loc. in Sec.
Anh.	844			NE SW NE
TP.	2834	2836	898	
H.	3107	3106	1168	
Tr.		3126	1188	
Dg.				
B.L.				
L.				Geol.
K.C.	3158	3157	1219	
B.K.C.				Contr.
Ce.				Co. tools
C.				
M.				Pool
M.				Emmeran
K.				
Mz.				
Me.				
V.				
S.				
S.				
A.	3422	3422	1484	
R.				
Pe.				
G.				
T.D.	3461			

Date Comm. 6-6-55 JUN 29 1955

8 5/8" @ 132/75 DST 2887-2902

open 1 hr. Rec. 5' socm 0/20"

DST 3158-3208 open 1 hr. Rec. 135' gas

15' socm 30' oil spotted mw 120' wtr.

940/20" DST 3225-55 open 1 hr. Rec.

15' gas 15' vsocm 100/20" DST 3400-

30 open 1 hr. Rec. 12' mud 100#

D & A

Co.

Lsc.

No.

Sec.

T.

R.