

Barton **KANSAS**
R. 12W

Sec. 25 Twp. 16 R. 12W

Well No. #7 Oser Farm

D. R. Lauck Company

Kraft-Prusa (Lauck, Cont.)

Pool


990' Ft. from N. Line

Ft. from S. Line

330' Ft. from E. Line

Ft. from W. Line

SE NE SE

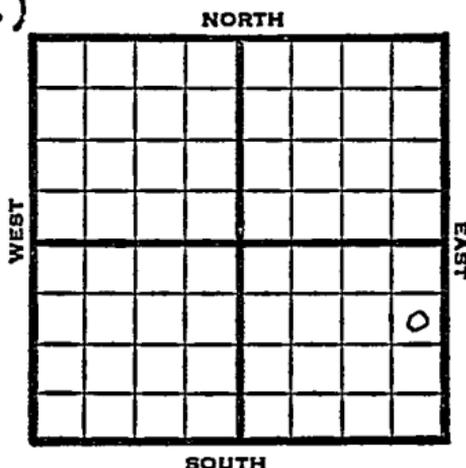

1949 Elev 1922' REPORT

8/10 Surface Hole

8/17 10" @ 251'
Drlg 2660'

8/24 "

8/31 Lansing 3049'
Quartzite 3278'
5" @ 3280'
TD 3295'
PB 3228-24
Shot 3155-51 sqz.

9/7 "

9/14 "

9/21 TD 3295'
Quartzite 3278'
Aband.

ABANDONED

Map No. _____ Sec. 25 Twp. 16 R. 12W

Well No. 7 Oser

D. R. Lauck Company

Lauck Contractor

SE NE SE

FIRST REPORT
SECTION PLAT

990 Ft. from N. Line

_____ Ft. from S. Line

330 Ft. from E. Line

_____ Ft. from W. Line

Barton County

Location _____

Rig up _____

Drilling and Remarks:

surface hole

RECORD

Cased _____ in., _____ ft.

Sand _____

Gas _____

Oil _____

Total Depth _____

PRODUCTION

1st 24 hrs. Nat. _____

1st 24 hrs. after shot _____

Gas _____ Cu. Ft.

Dry Hole _____

Abandoned _____

Date

AUG 10 1949 19

S. J. LEWIS Scout

Kansas

Map No. K55 Sec. 25 Twp. 16 R. 12WWell No. 7 OserD. R. Lauck CompanyABANDONED Contractor

SE NE SE

E 1 1922.
SECTION PLAT990 Ft. from N. Line

Ft. from S. Line

330 Ft. from E. Line

Ft. from W. Line

Barton County

Location _____

Rig up _____

Drilling and Remarks:

I was 1575 to 3175.

RECORD

Cased _____ in., _____ ft.

Sand _____

Gas _____

Oil _____

Total Depth 3295

PRODUCTION

1st 24 hrs. Nat. _____

1st 24 hrs. after shot _____

Gas _____ Cu. Ft.

Dry Hole _____

Abandoned _____

Date

SEP 21 1949 19S. J. TEWIS Scout