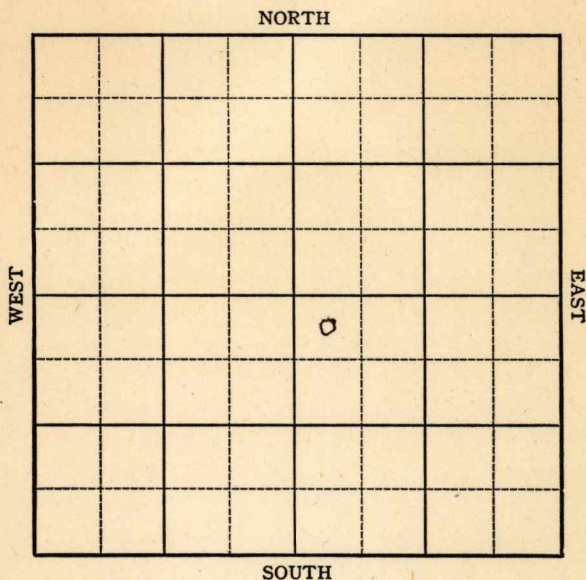


KANSAS

Ellis county

Section 26 Township 12 Range 16-WWell No. #1, FurthmeyerCompany Hubert Alco.

KANSAS

Ellis

Sec. 26 Twp. 12 R. 16W

Well No. #1 Furthmeyer Farm

H ubert Alco. Company


Wildcat

330 Ft. from N. Line

Ft. from S. Line

Ft. from E. Line

330 Ft. from W. Line

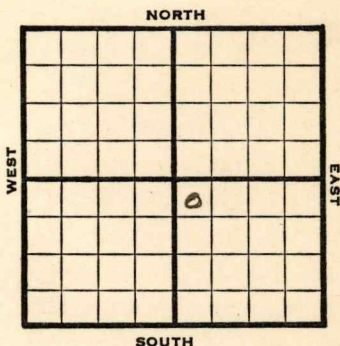

NW SE

1946

Elev. 1996'

REPORT

10/9 Location

10/15 Surface hole

10/22 8" @ 209'

Anhy 1145'

Drlg 2230'

10/29 Lans 3220

Drlg 3383'

11/6 Arb 3485'

TD 3520'

ABANDONED

Map No. 71 Sec. 26 Twp. 12 R. 16W

Well No. 1 Furthmeyer

Hubert Alco. Company

FIRST REPORT

Contractor

NW SE


SECTION PLAT

330 Ft. from N. Line

 Ft. from S. Line

 Ft. from E. Line

330 Ft. from W. Line

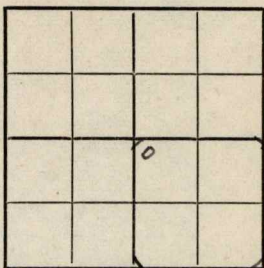

Ellis County

Location X

Rig up

Drilling and Remarks:

RECORD

Cased in., ft.

Sand

Gas

Oil

Total Depth

PRODUCTION

1st 24 hrs. Nat.

1st 24 hrs. after shot

Gas Cu. Ft.

Dry Hole

Abandoned

Date

OCT 9 1946 19 S. J. LEWIS Scout

Map No. 71 Sec. 26 Twp. 12 R. 16W

Well No. 1 Furthmeyer

Huber & Alco Company

ABANDONED Contractor

NW SE

E 1, 1996
SECTION PLAT

330 Ft. from N. Line

_____ Ft. from S. Line

_____ Ft. from E. Line

330 Ft. from W. Line

		0	

Ellis County

Location _____

Rig up _____

Drilling and Remarks:

See 83485

RECORD

Cased _____ in., _____ ft.

Sand _____

Gas _____

Oil _____

Total Depth 8520

PRODUCTION

1st 24 hrs. Nat. _____

1st 24 hrs. after shot _____

Gas _____ Cu. Ft.

Dry Hole _____

Abandoned _____

Date

NOV 6 1946 19 S. J. LEWIS Scout