


Section 26 Township 12 Range 16WWell No. #2 SitsCompany Kewanee Oil

NORTH

WEST

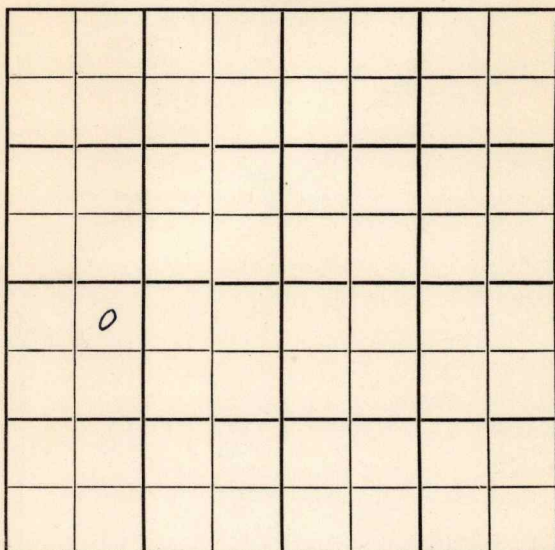

EAST

SOUTH

Ellis

KANSAS

Sec. 26 Twp. 12 R. 16 W

Well No. # 2 Sits Farm

Kewanee Oil Company

Gross Drlg. - Contr. NE Emmerman Pool Contractor


330 Ft. from N. Line

 Ft. from S. Line

 Ft. from E. Line

990 Ft. from W. Line

NE NW SW

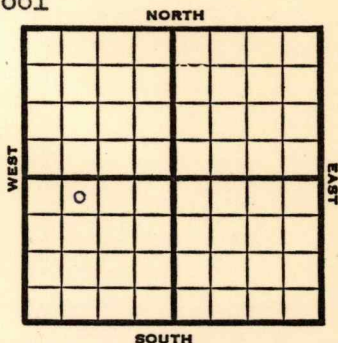

1951

Elev. 2035' REPORT

5/23

Location

7/11

Spud 5-25-51
D&A TD 3527
10' @ 216 Anhy 1170-1210
Heeb. 3192 Dodge 3207
Lans. 3241 BKC 3486
Arb. 3516 TD 3525
5" @ 3518 FU 1600' wtr
DD 3527
8/3515-19 2 go 24/3515-19
1½ go ½ gsw 7 hr SP 3310
10/3273-77 1½ gsw SS0 12/3290-94
25 gsw SP 3262 12/3242-50
5 gsw 34 gsw 2½ goph SP 3226
12/3218-22 12/3208-12 wtr
500 A 8 go 4 gswph 2000 A
S/21 bw 4 bo 15 hrs. D&A

ABANDONED

County Ellis State KansasSec. 26 (Blk.
Twp.) 12 (Sur.
Rge.) 16W Map No.Operator Kewanee OilWell No. 2 Farm SitsElev. 2035 Location NE NW SW330Ft. From N Line SW990Ft. From W Line Quarter1st. ReportCompletion JUL 11 1951Remarks NE Emmerman PoolGross Drlg. - Contr.Spudding Date 5-25-51Drlg. Data D & A TD 352710" @ 216 Anhy 1170-1210Heeb. 3192 Dodge 3207 Lans. 3241B KC 3486 Arb. 3516 TD 35255" @ 3518 FU 1600' water DD 35278/ 3515-19 2 go 24/ 3515-191½ go ½ gsw 7 hr. SP 331010/ 3273-77 1½ gsw SS0 12/ 3290-94 25 gsw SP 3262 12/ 3242-505 gsw 34 gsw 2½ goph SP 322612/ 3218-22 12/ 3208-12 water500 A 8 go 4 gswph 2000 AS/ 21 bw 4 bo 15 hr.D & A

U. E. TYRA